


T.2S.R.2W.W.M.

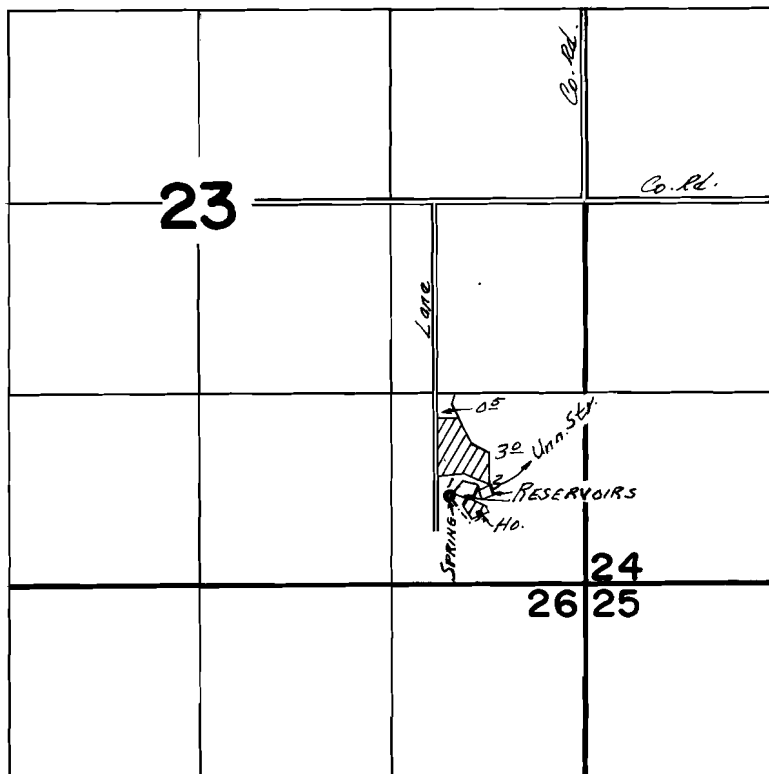

SPRING LOC. - 600' N & 920' W } All from SE Cor.
 RES. #1 DIV. - 650' N & 750' W } SEC. 23
 RES. #2 DIV. - 650' N & 650' W }

FINAL PROOF SURVEY

UNDER

R-51533

R-6239

51534

38824

R-47653

R-5739

Application No. 47654 Permit No. 35657

IN NAME OF

DAVID G. METZGER

Surveyed July 25 1978, by R.G. Mucken