


T.1N.R.4W.W.M.

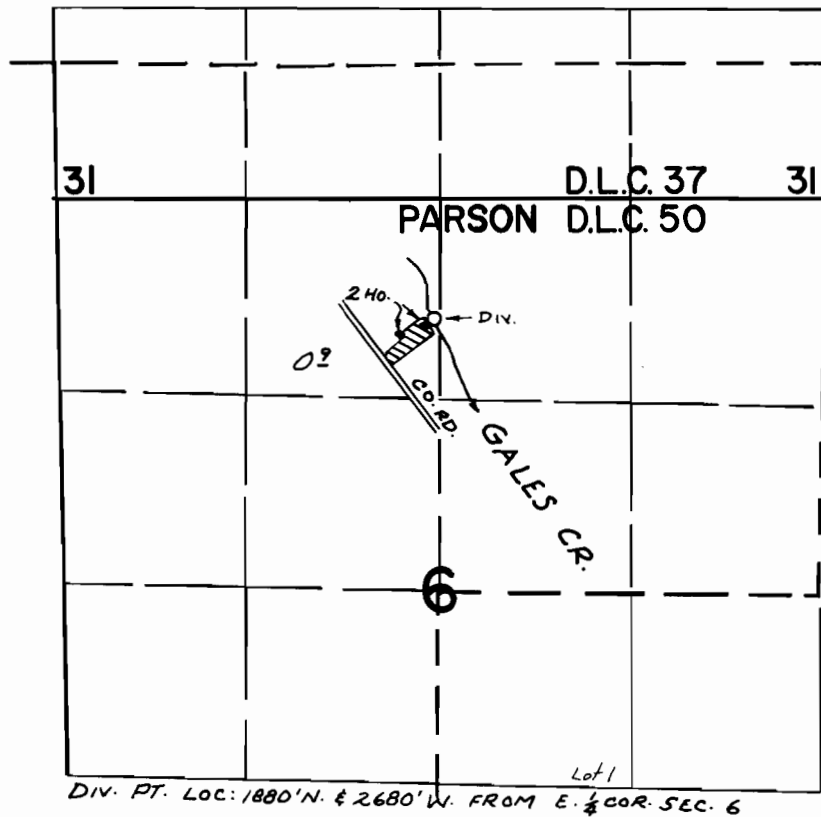

**FINAL PROOF SURVEY**  
UNDER

Application No. 52299 Permit No. 39344  
IN NAME OF

HAL N. WINELAND & MARGARET S. PAYTON

Surveyed MAY 4, 1979, by R. MUCKEN