


T3N. R4W. WM.

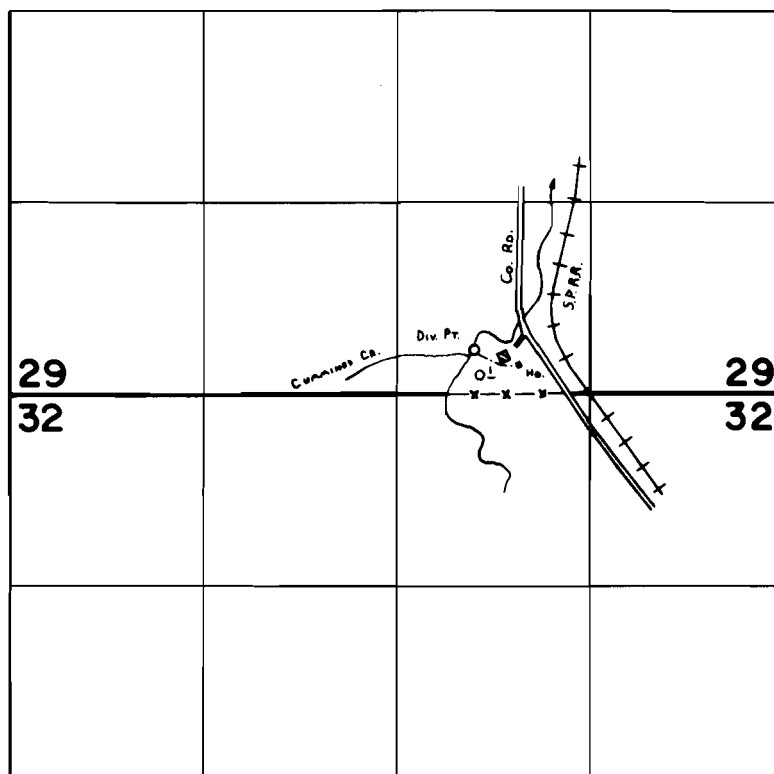

DIV PT LOC: 310' N. & 530' E. fr. S. 1/4 SEC. 29.

FINAL PROOF SURVEY
UNDER

Application No. 54334 Permit No. 40578
IN NAME OF

Stephen V. and/or Sharon A. Yates

Surveyed AUG 8 1978, by C L HUGHES