


T.12S.,R.22&23E.,W.M.

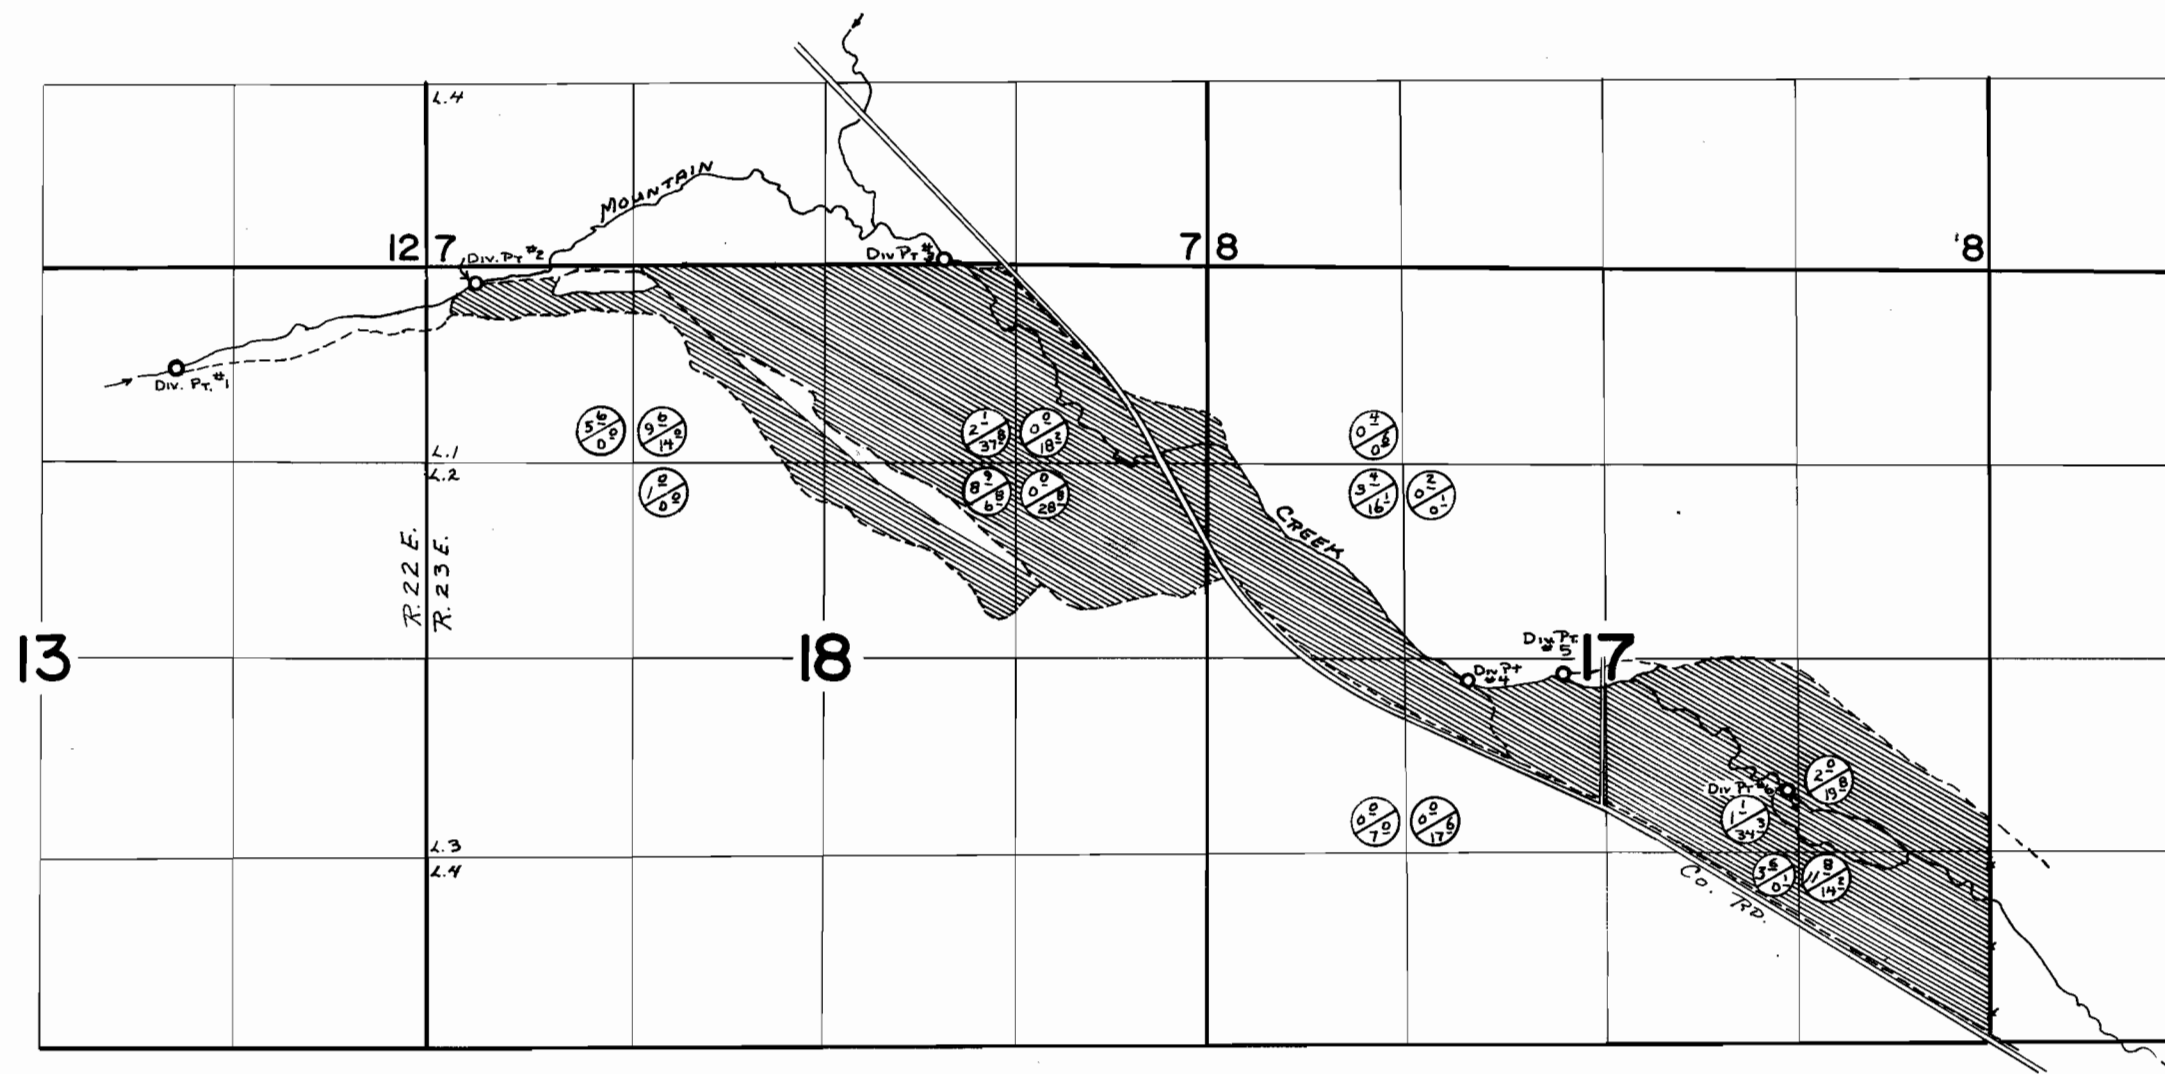

- Div. Pt. #1- 700' S AND 1710' W FROM NE COR. SEC. 13
 Div. Pt. #2- 120' S AND 380' E FROM NW COR. SEC. 18
 Div. Pt. #3- 40' N AND 1800' W FROM SE COR. SEC. 7
 Div. Pt. #4- 150' S AND 940' W FROM C¹/₄ COR. SEC. 17
 Div. Pt. #5- 100' S AND 290' W FROM C¹/₄ COR. SEC. 17
 Div. Pt. #6- 920' S AND 1250' E FROM C¹/₄ COR. SEC. 17

-  A - LAND IRRIGATED IN EXCESS OF EXISTING RIGHTS
 B - LAND IRRIGATED UNDER EXISTING RIGHTS

FINAL PROOF SURVEY UNDER

Transfer No. B-174
M-170
 Application No. 41544 Permit No. 30990

IN NAME OF

DONALD E. MCGHEHEY

Surveyed Aug. 7, 1974 by L. H. NUNN