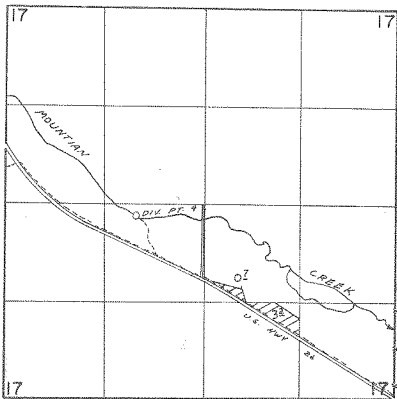


T.12S. R.23E. W.M.

DIV. PT. 4 LOC. 150 S. & 940' W FROM CENTER $\frac{1}{4}$ COR. SEC. 17

FINAL PROOF SURVEY UNDER

Application No. 43226 Permit No. 32317
IN NAME OF

Brooks Resources Corp.

Surveyed AUG. 7, 1974, by L.H. NUNN