


T.4S.,R.5W.,W.M.

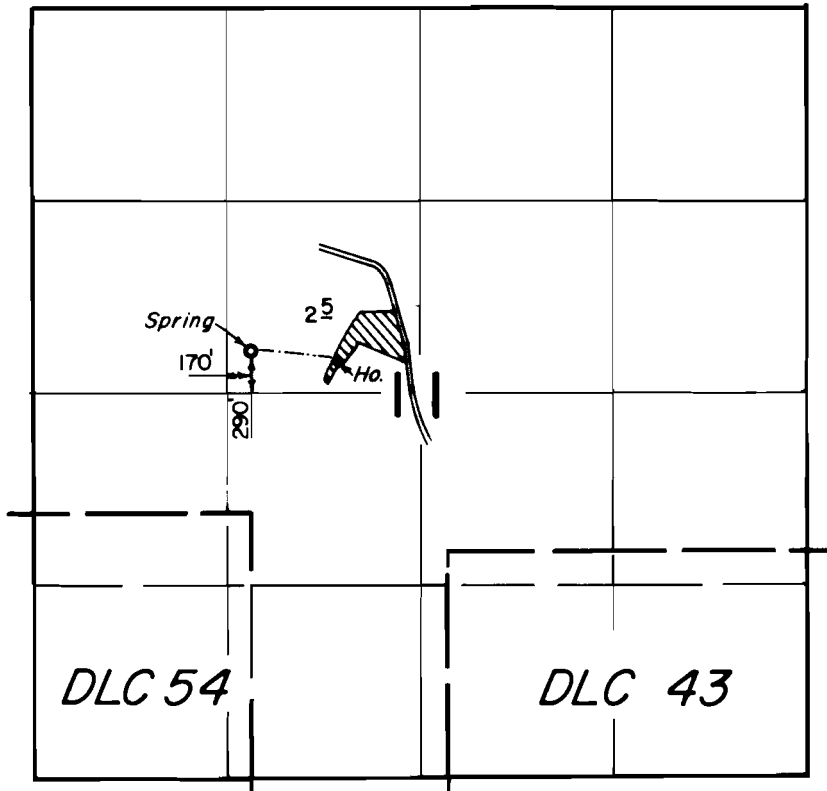

FINAL PROOF SURVEY
UNDER

Application No. **54061** Permit No. **40430**

IN NAME OF

ROBERT T. KELLER

Surveyed **JUNE 4, 1980**, by *[Signature]*