


T.5S., R.3W., W.M.

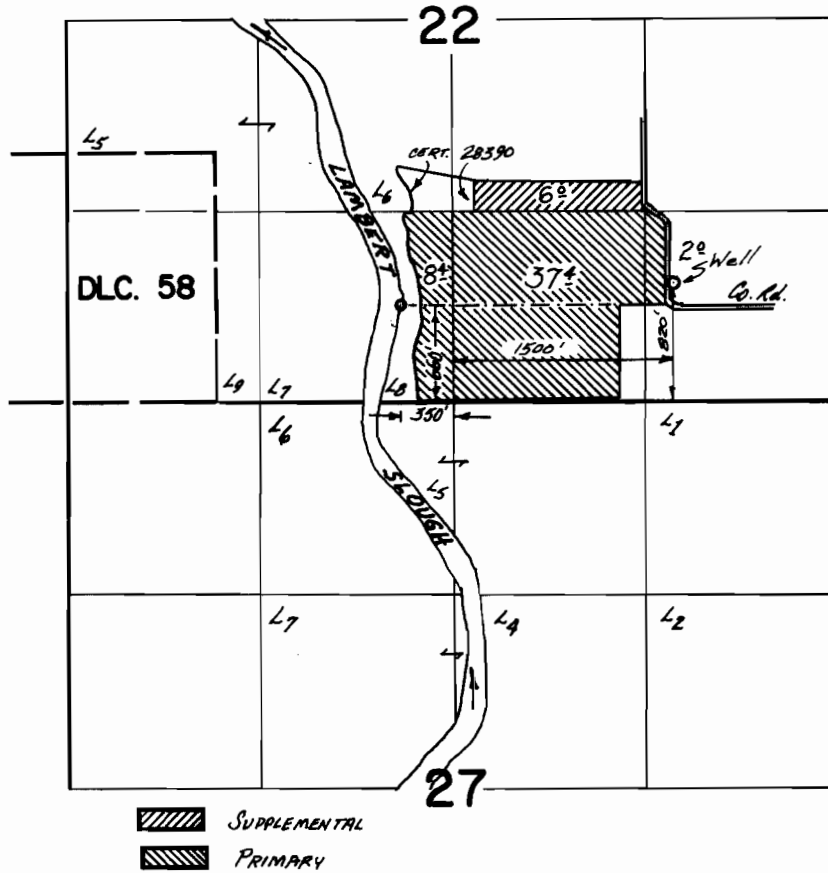

FINAL PROOF SURVEY
UNDER

G-7770 G-7180
Application No. 43482 Permit No. 32523
IN NAME OF

JAMIE W. & PATRICIA EDIGER

Surveyed 10 Nov. 1972, by D. NORBY
28 MAY 1980, *[Signature]*