


T.27 S.R.11 W.W.M.

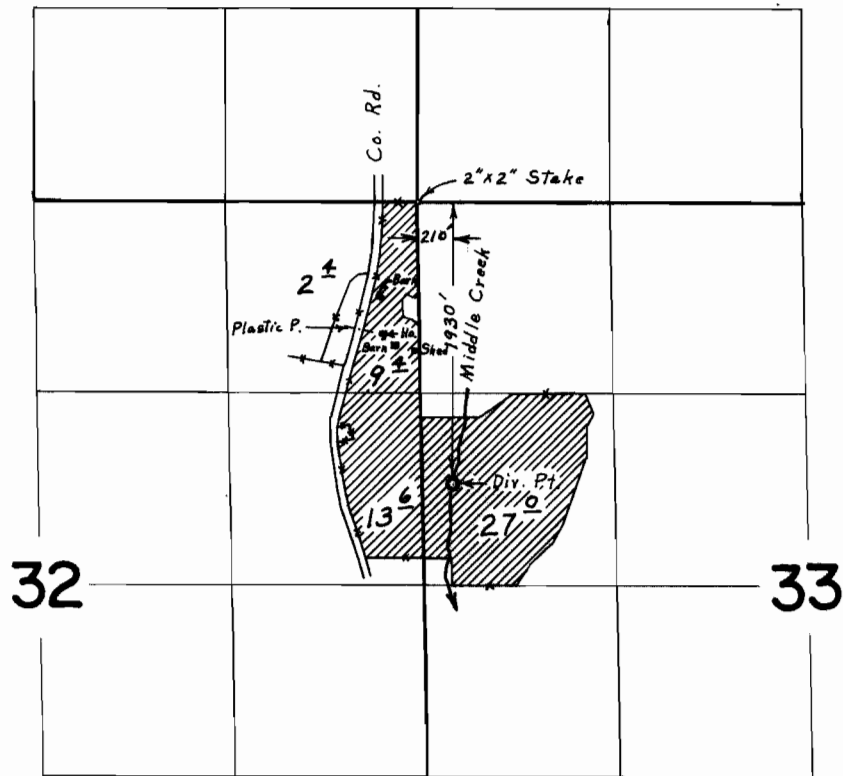

FINAL PROOF SURVEY
UNDER

Application No. 39508 Permit No. 29321
IN NAME OF

EDWARD GRANT JOHNSON

Surveyed May 16, 1967, by L. E. Gould