


T.15S., R.46E., W.M.

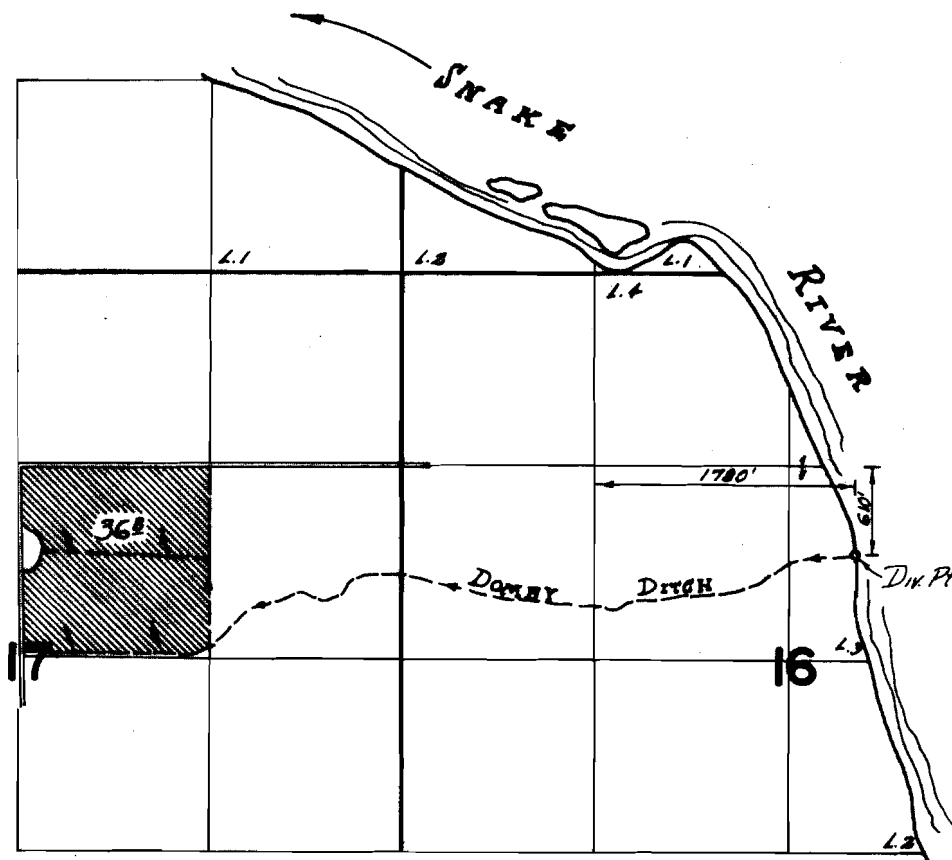

FINAL PROOF SURVEY
UNDER

Application No. 45390 Permit No. 33889
IN NAME OF

CHENEY BROS.

Surveyed MAY 30 1973, by D. NORBY