


T. 7 S. R. 1 W. W.M.

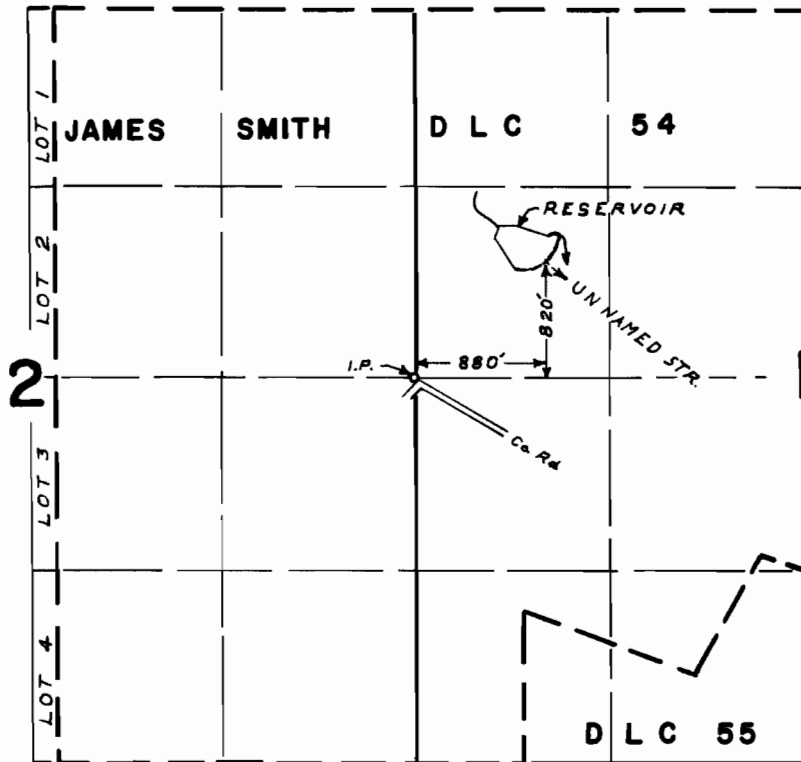

FINAL PROOF SURVEY
UNDER

Application No. **R-44268** Permit No. **R-5118**
IN NAME OF

LEWIS MELLBYE

Surveyed **SEPT. 6** 1968, by **L. E. GOULD**