



T.182N.R.13E.W.M.

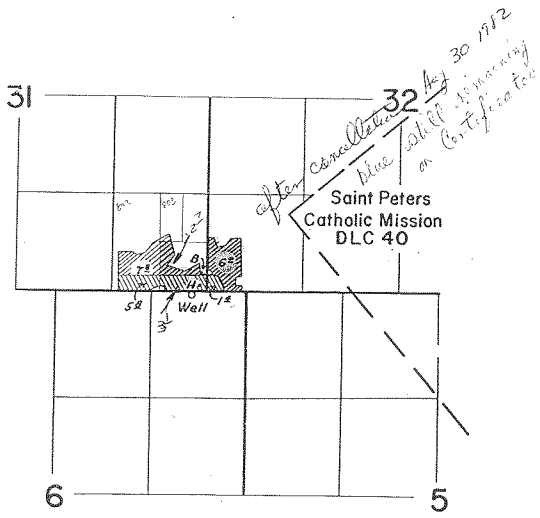

FINAL PROOF SURVEY
UNDER

Application No. G-1689 Permit No. G-292 
IN NAME OF

Arthur R. & Mary M. Anderson

Surveyed April 10 1962, by Thomas R. Lauer