


T.14S., R.8W. W.M.

IRRIGATION: SPRING #1 
DRAINAGEWAY 

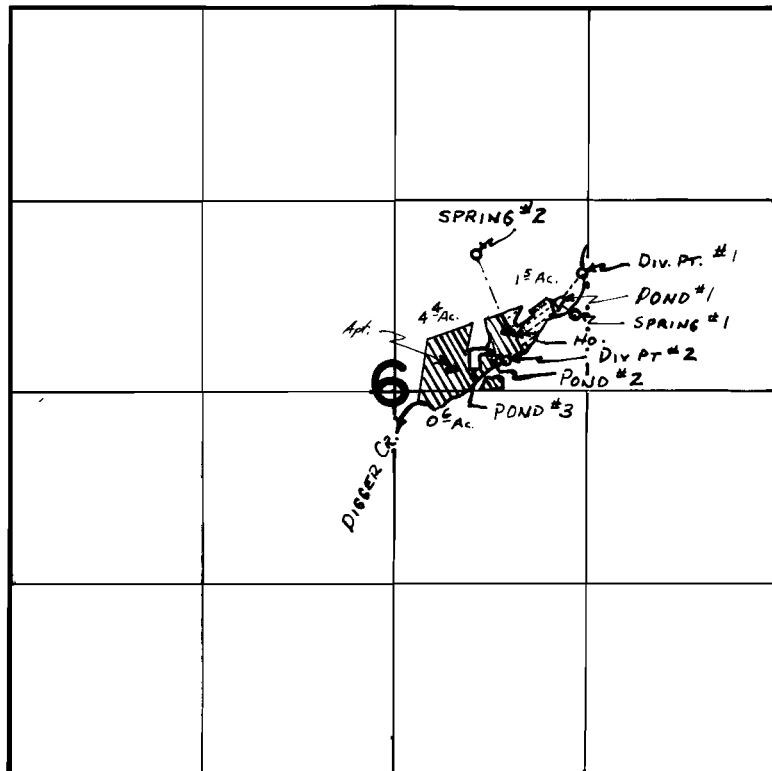

DIGGER CREEK #1- 810' N. { 1280' E.
DIV. PTS: #2- 200' N. { 770' E.
SPRINGS LOC: #1- 530' N. { 1240' E.
#2- 930' N. { 560' E.
DRAINAGEWAY
Div. Pt.: 150' N. { 550' E.

ALL FROM C. 1/4 COR. SEC. 6.

FINAL PROOF SURVEY UNDER

R-52542 R-6379
Application No. 52543 Permit No. 39810...
IN NAME OF

JOHN C. & BETTY L. SCHUTTE

Surveyed Sept. 22, 1977, by R.F. BARWIN...
Inspection May 20, 1980 by C. Hughes