


T.14S., R.8W. W.M.

IRRIGATION: SPRING #1 
 DRAINAGEWAY 

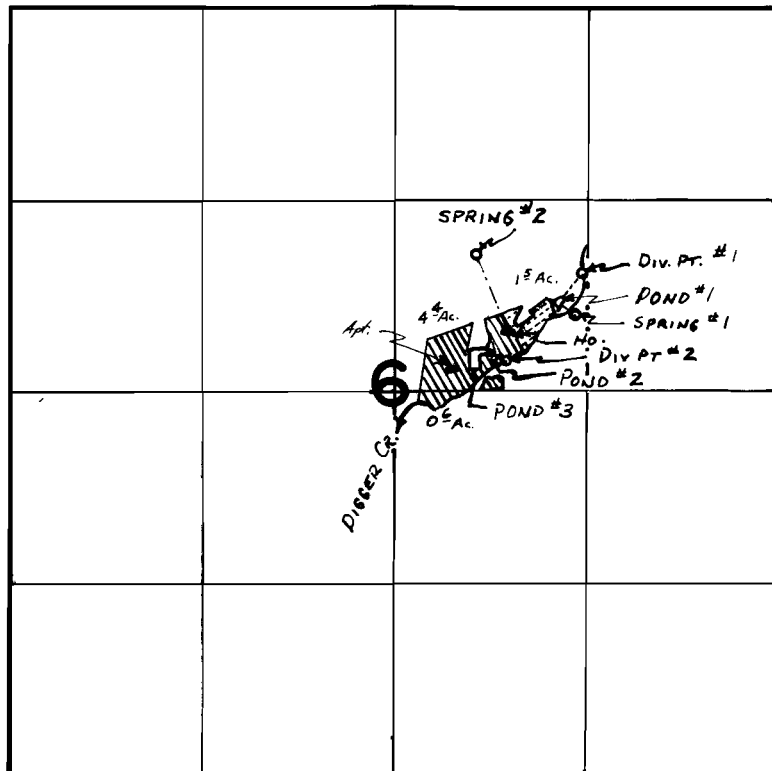

DIGGER CREEK #1- 810' N. & 1280' E.
 DIV. PTS: #2- 200' N. & 770' E. } ALL FROM C. 1/4 COR. SEC. 6.
 SPRINGS LOC: #1- 530' N. & 1240' E.
 #2- 930' N. & 560' E.
 DRAINAGEWAY
 Div. Pt.: 150' N. & 550' E.

FINAL PROOF SURVEY UNDER

R-52542 R-6379
 Application No. 52543 Permit No. 39810...
 IN NAME OF

JOHN C. & BETTY L. SCHUTTE

Surveyed Sept. 22, 1977, by R.F. BARWIN...
 Inspection May 20, 1980 by C. Hughes