


P-5430-2
Nov. 1964
(formerly A1-29)

UNITED STATES
DEPARTMENT OF THE INTERIOR
BUREAU OF LAND MANAGEMENT

SECTION DIAGRAM

MAP CONTRACT No. 14-11-0001()-
T. 19 S. R. 22 E. SEC. 8 , Will. MER. Prineville DISTRICT
MAPPER _____ DATE _____

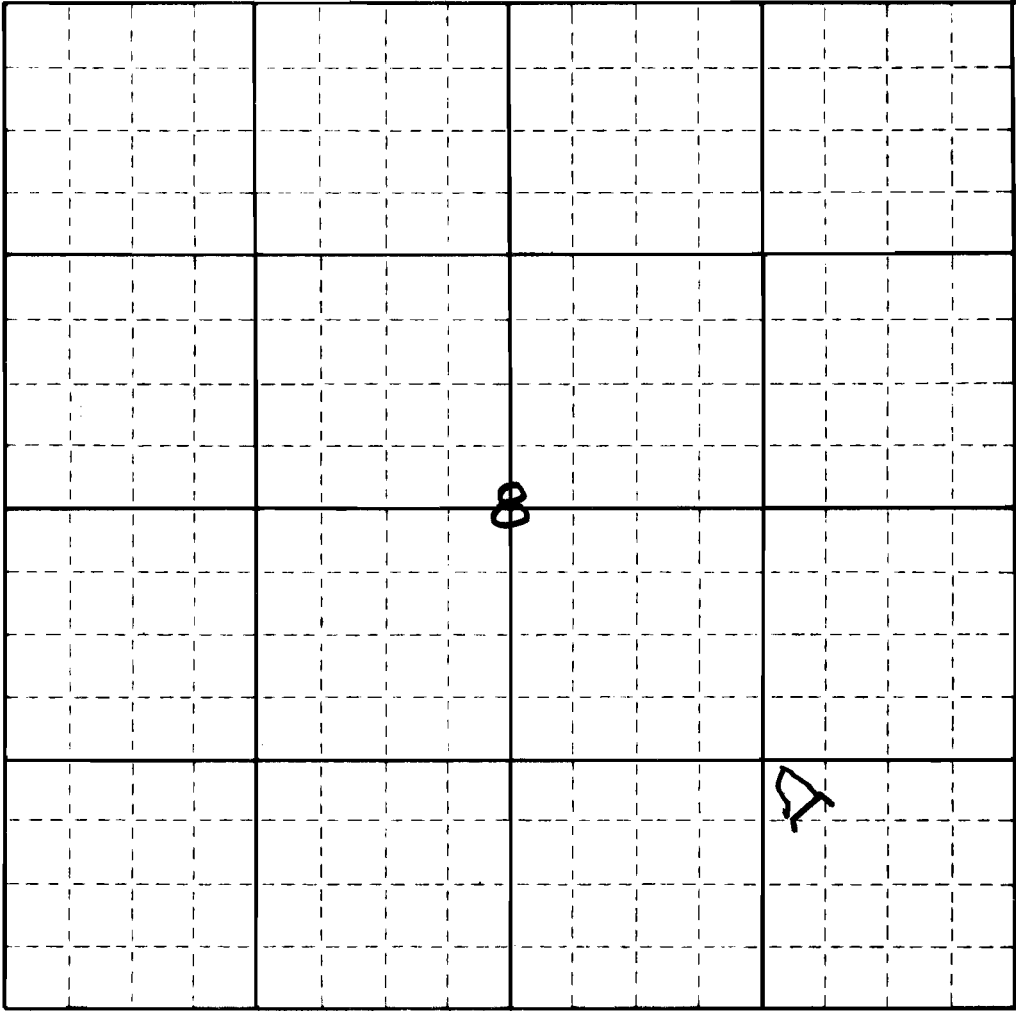

SCALE: 1" = 1,000 FT.

LEGEND

- | | | | |
|--------------------------|-------|--------|----------------------------------|
| ☐ | _____ | ===== | MAINLINE ROAD |
| ☐ | _____ | ==== | PROPOSED SPUR ROADS |
| ☐ | _____ | 000000 | YARDING ROADS (CAT OR HIGH LEAD) |
| ☐ | _____ | ⊗ | SPUR TREES (YARDING OR LOADING) |
| ☐ | _____ | ● | CORNERS FOUND |
| ☐ | _____ | ---- | BOUNDARY - CONTRACT AREA |
| ☐ | _____ | ---- | BOUNDARY - CUTTING AREA |

RECEIVED

NOV 14 1973

STATE ENGINEER

SALES OFFICE

Application No. R-51392
Permit No. R 7524