



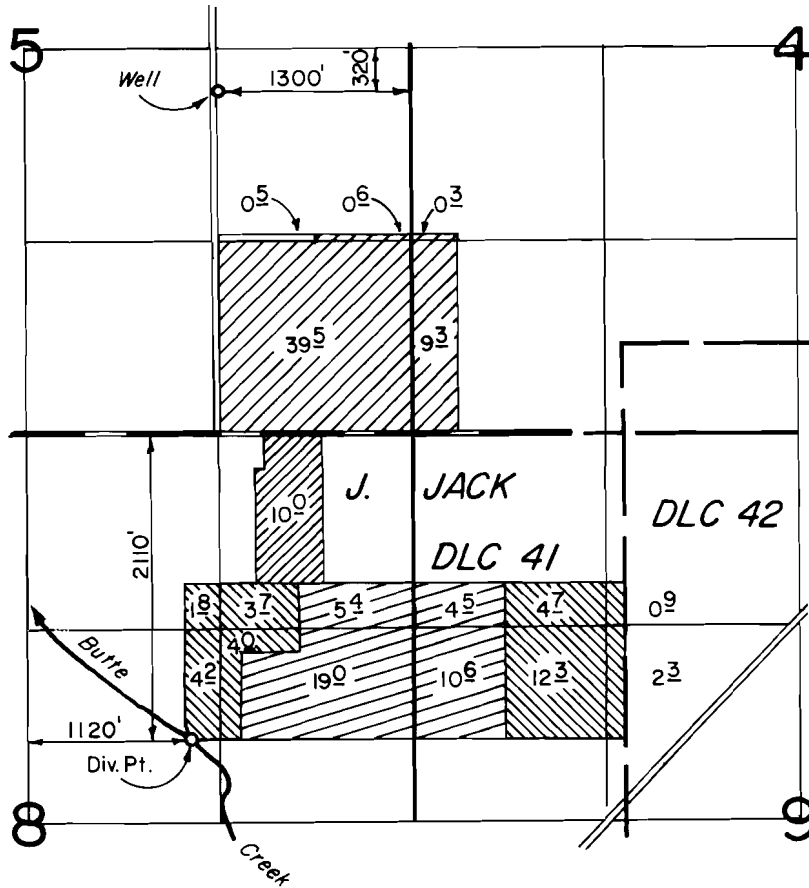


# T.6S.,R.1E.,W.M.

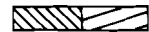

## FINAL PROOF SURVEY UNDER

G-7870                      G-7291  
 55397                      41538  
 Application No. 57217      Permit No. 42996

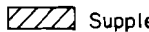 Supplemental  
 Primary  
 Primary     Supplemental

IN NAME OF

**VICTOR SCHNEIDER et al.**

Surveyed MAY 1, 1978, by J. DONALDSON  
MAY 19, 1980

*J. Brown*

*deb*