


P-5430-2
Nov. 1964

UNITED STATES
DEPARTMENT OF THE INTERIOR
BUREAU OF LAND MANAGEMENT

SECTION DIAGRAM

MAP CONTRACT No. 14-11-0001()-
T. 18 S. R. ~~22E~~ SEC. 33, Will. MER. Prineville DISTRICT
MAPPER _____ DATE _____

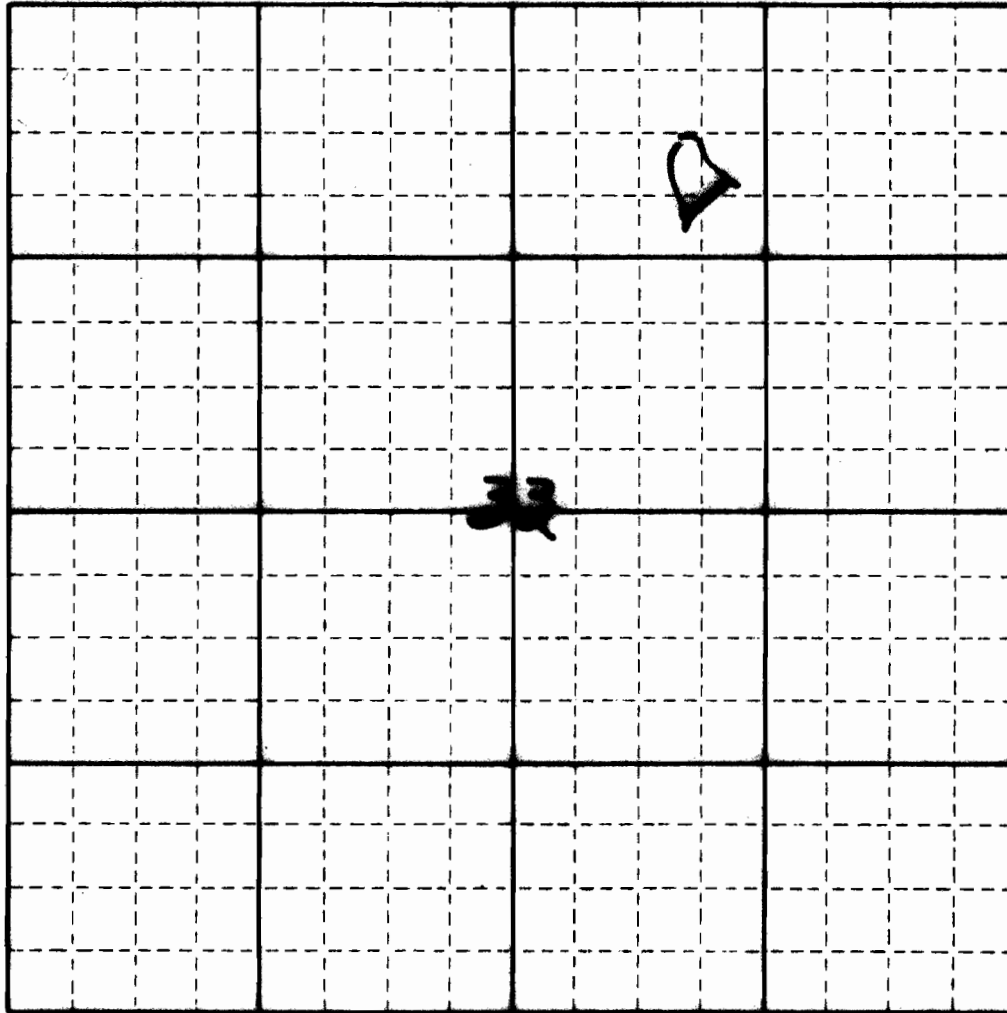

Application No. P-5430-2
Permit No. 7516
A-51417

SCALE: 1" = 1,000 FT.

LEGEND



RECEIVED

NOV 14 1973

STATE ENGINEER
SALEM, OREGON

Located on BLM quad



MAINLINE ROAD

PROPOSED SPUR ROADS

YARDING ROADS (CAT OR HIGH LEAD)

SPAR TREES (YARDING OR LOADING)

CORNERS FOUND

BOUNDARY - CONTRACT AREA

BOUNDARY - CUTTING AREA