


T. 32S., R. 4W., W.M.

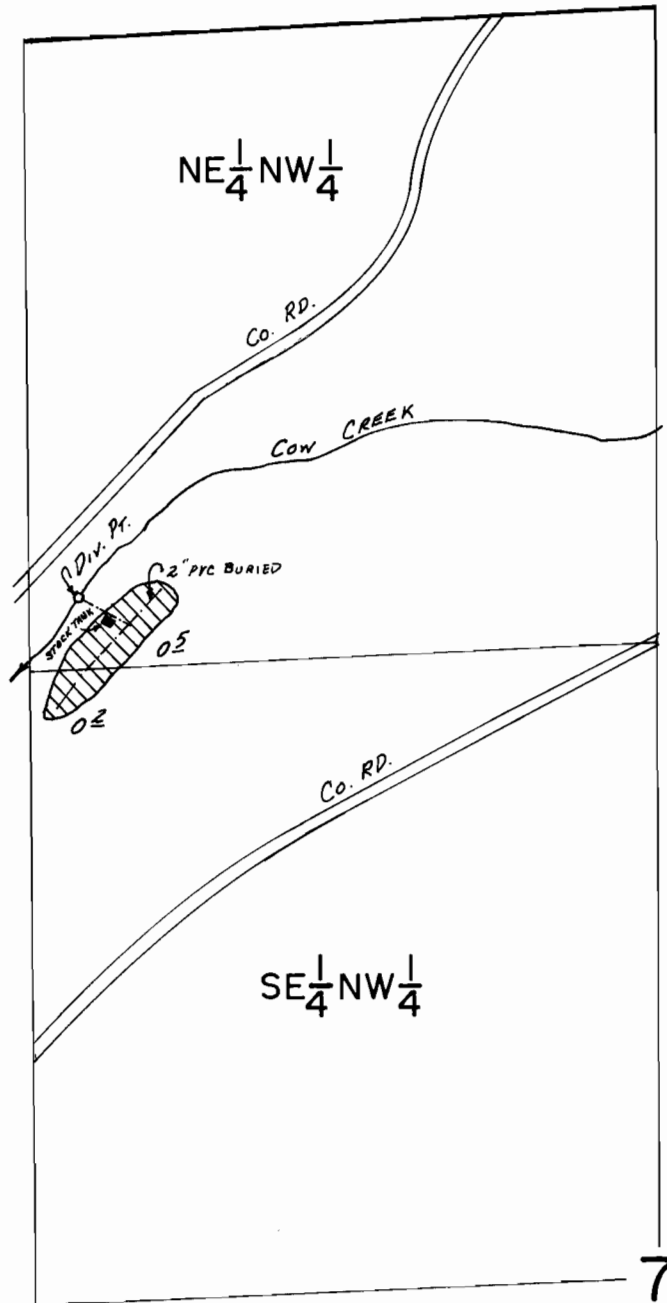

DIV. PT. LOC.: 1230'S. & 1205'W. FROM N1/4 COR. SEC. 7

SCALE: 1" = 400'

### FINAL PROOF SURVEY

UNDER

Application No. 53171..... Permit No. 38810.....  
IN NAME OF

.....Joseph M. & Irene G. Campeau.....

Surveyed Oct. 17..... 1979., by J.S. DONALDSON