

UNITED STATES
DEPARTMENT OF THE INTERIOR
BUREAU OF LAND MANAGEMENT

SECTION


17

Oregon State Water Filings

SE 1/4 SE 1/4

TOWNSHIP 30S, RANGE 28E, W. M.

North

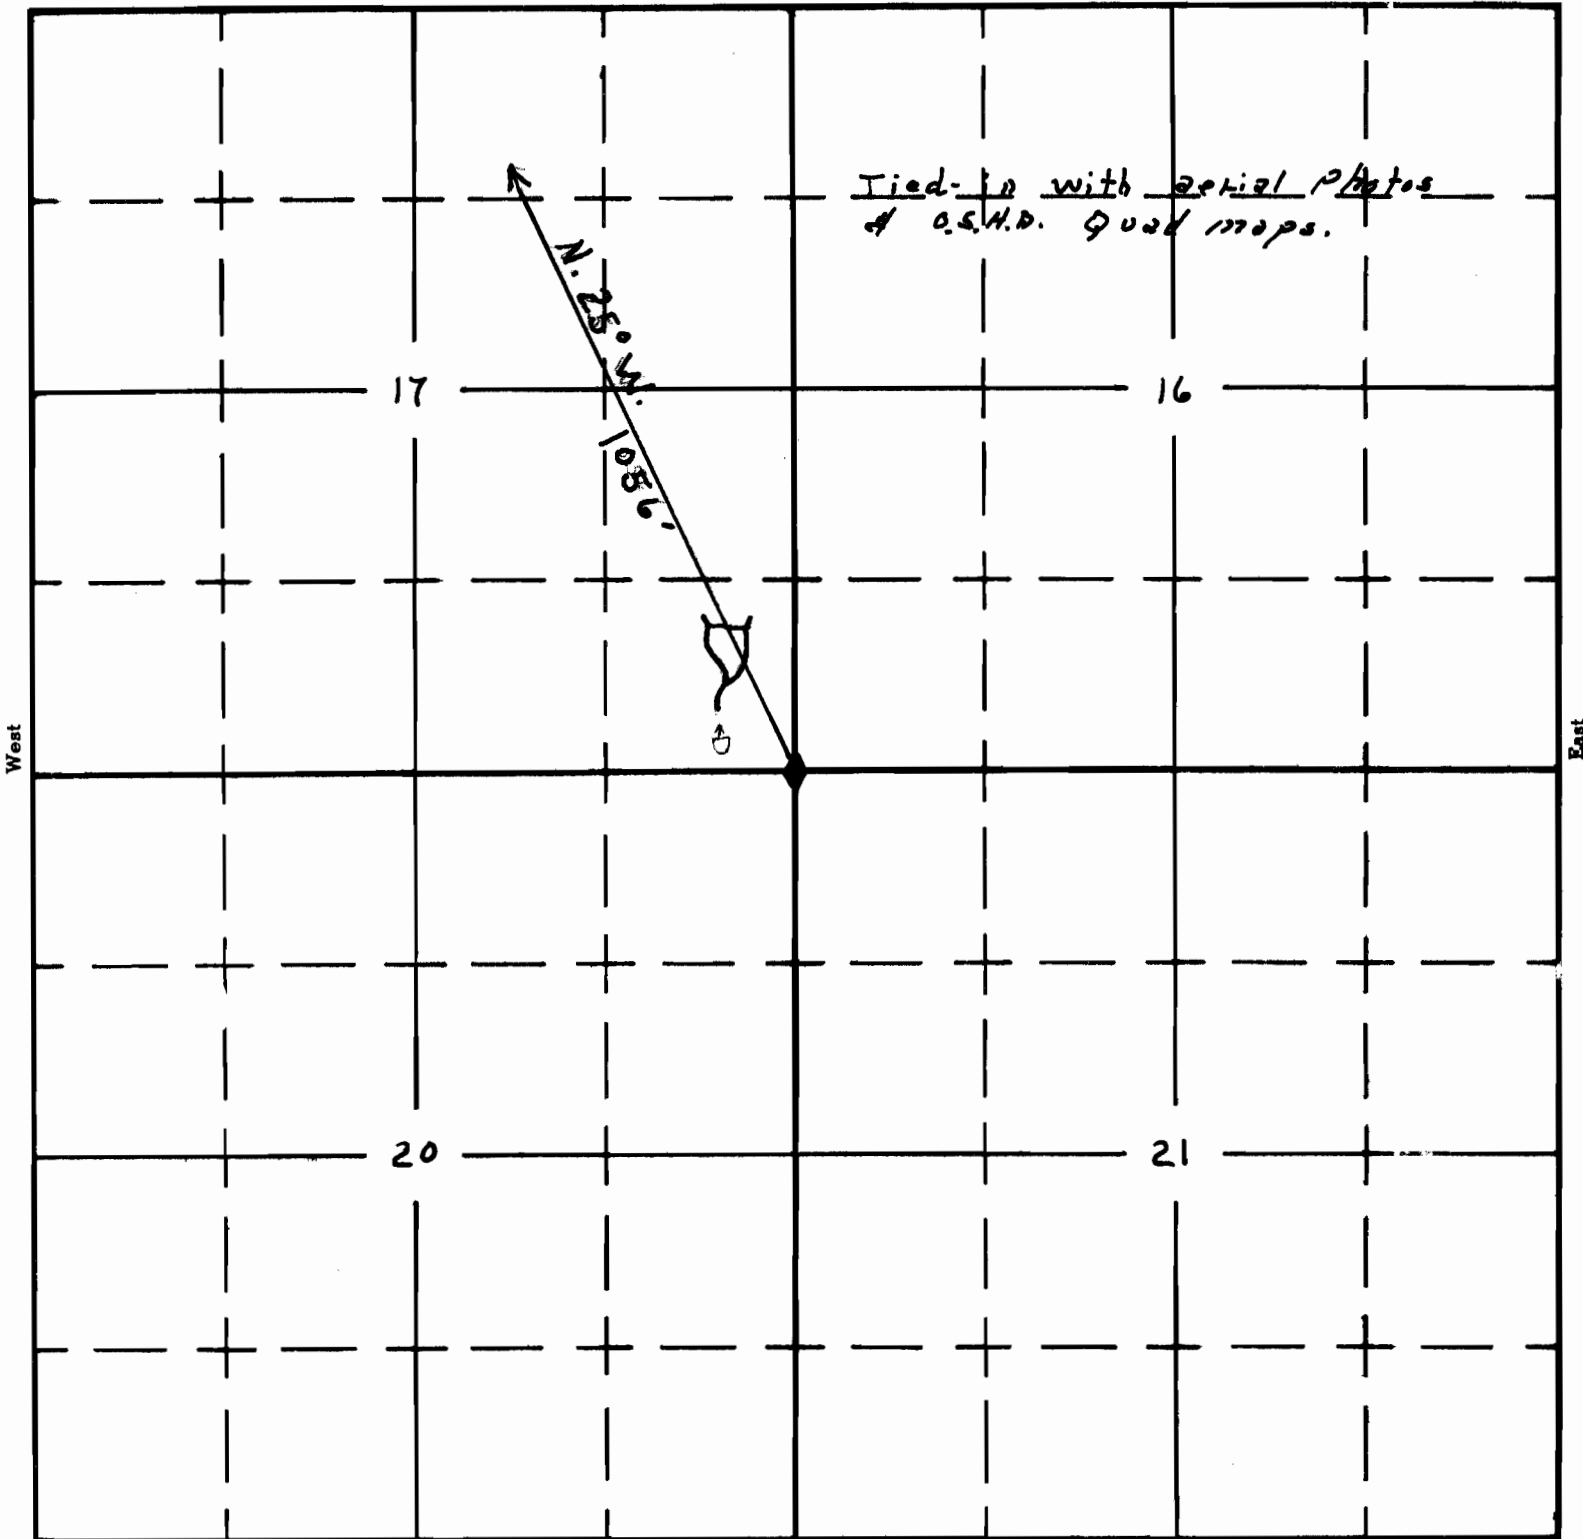

Balls Lake 7 1/2' quad

South

APPLICATION No. R-35122
PERMIT No. R-2829