


Oregon State Water Filings

TOWNSHIP 32S, RANGE 25E, W. M.

Tied in with aerial photos & O.S.H.D. Quad Maps

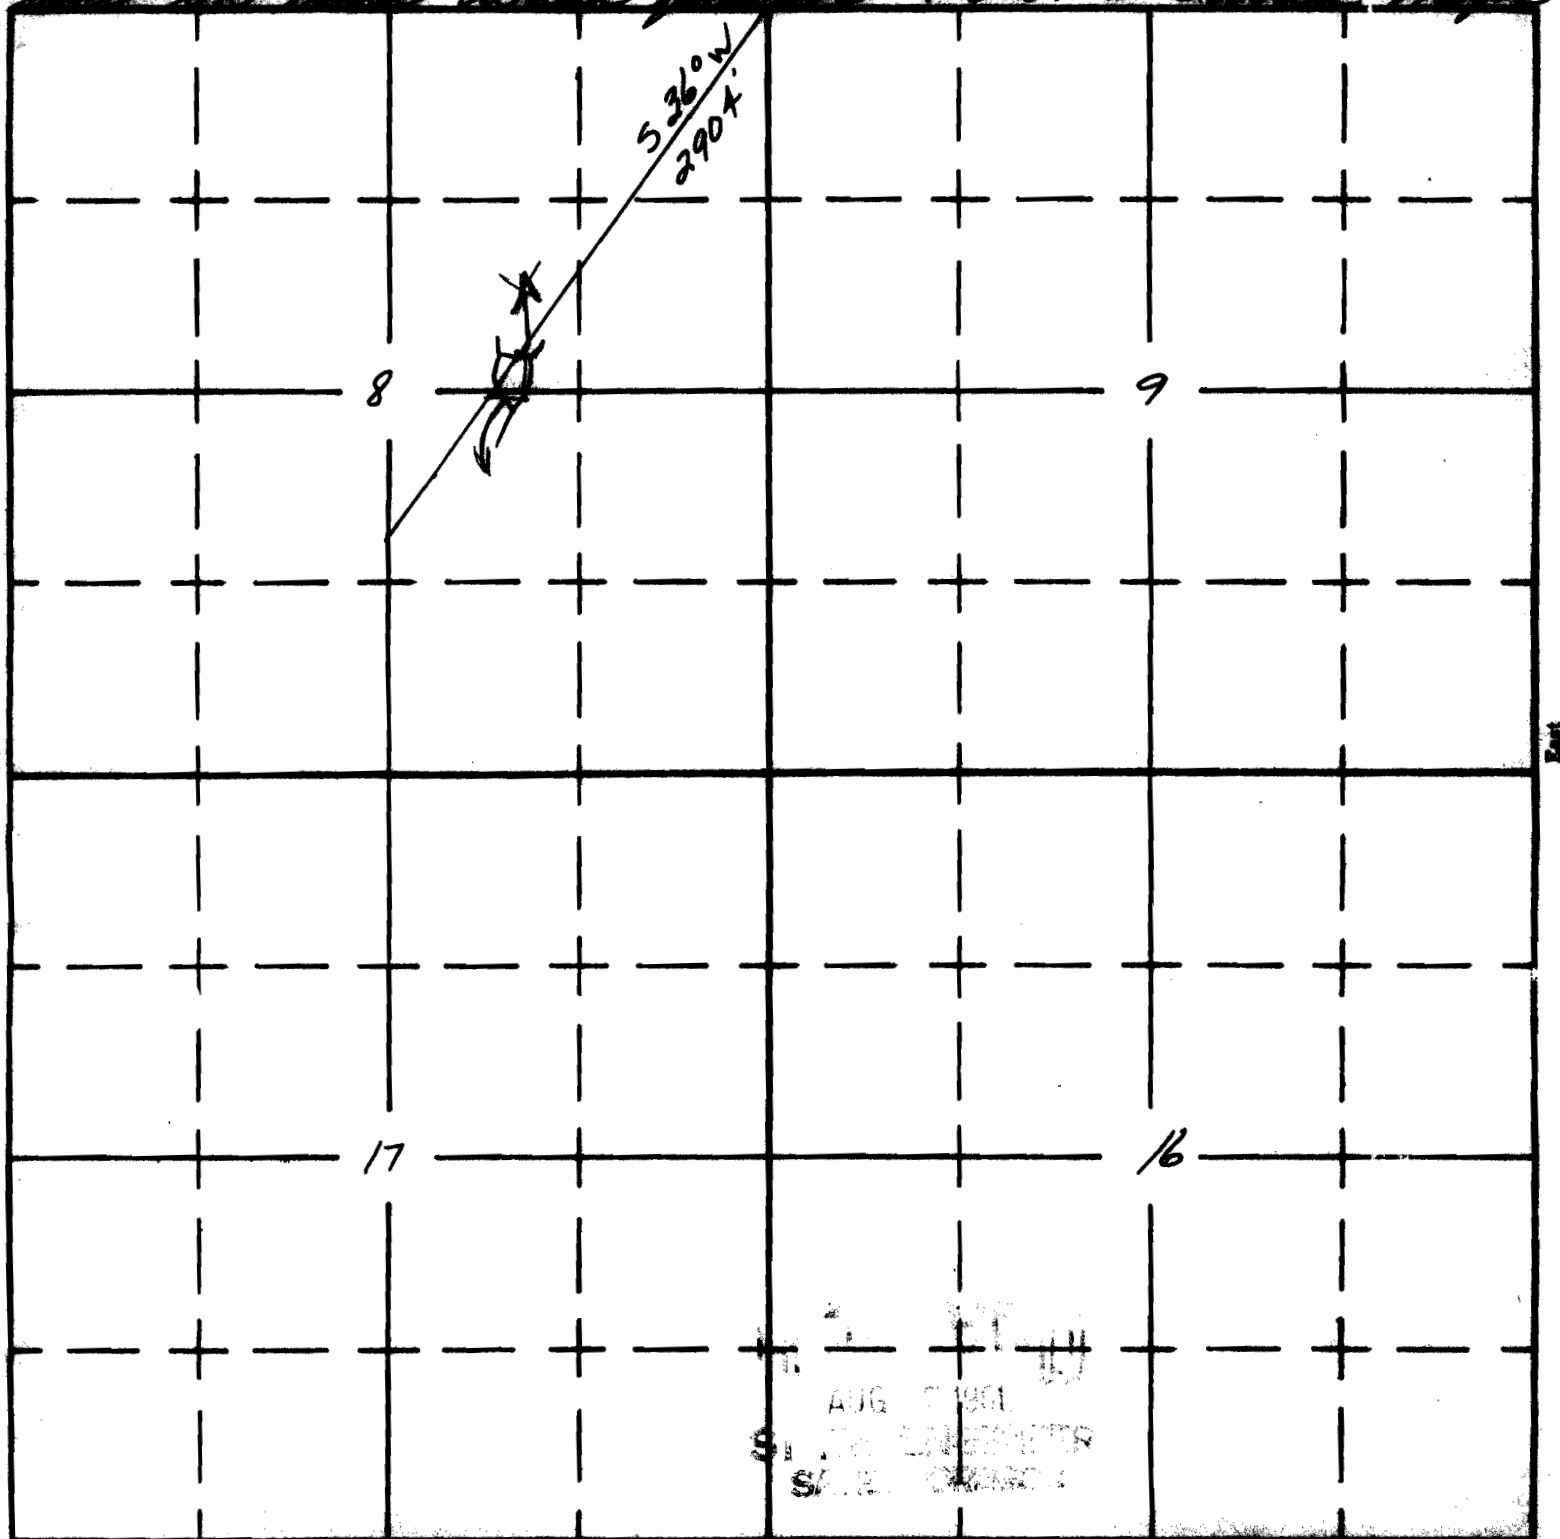

No USGS quod

South

Hwy quad Flagstaff Lake 2

APPLICATION No. R-36/33

DOCUMENT NO. **P-3567**