

Form A1-187  
March 1961

UNITED STATES  
DEPARTMENT OF THE INTERIOR  
BUREAU OF LAND MANAGEMENT

R 3571  
51370


SECTION

33  
NE 1/4 NW 1/4


TOWNSHIP 30S, RANGE 27E, W. M.

North Tied in with aerial photo and OSND Quad maps.

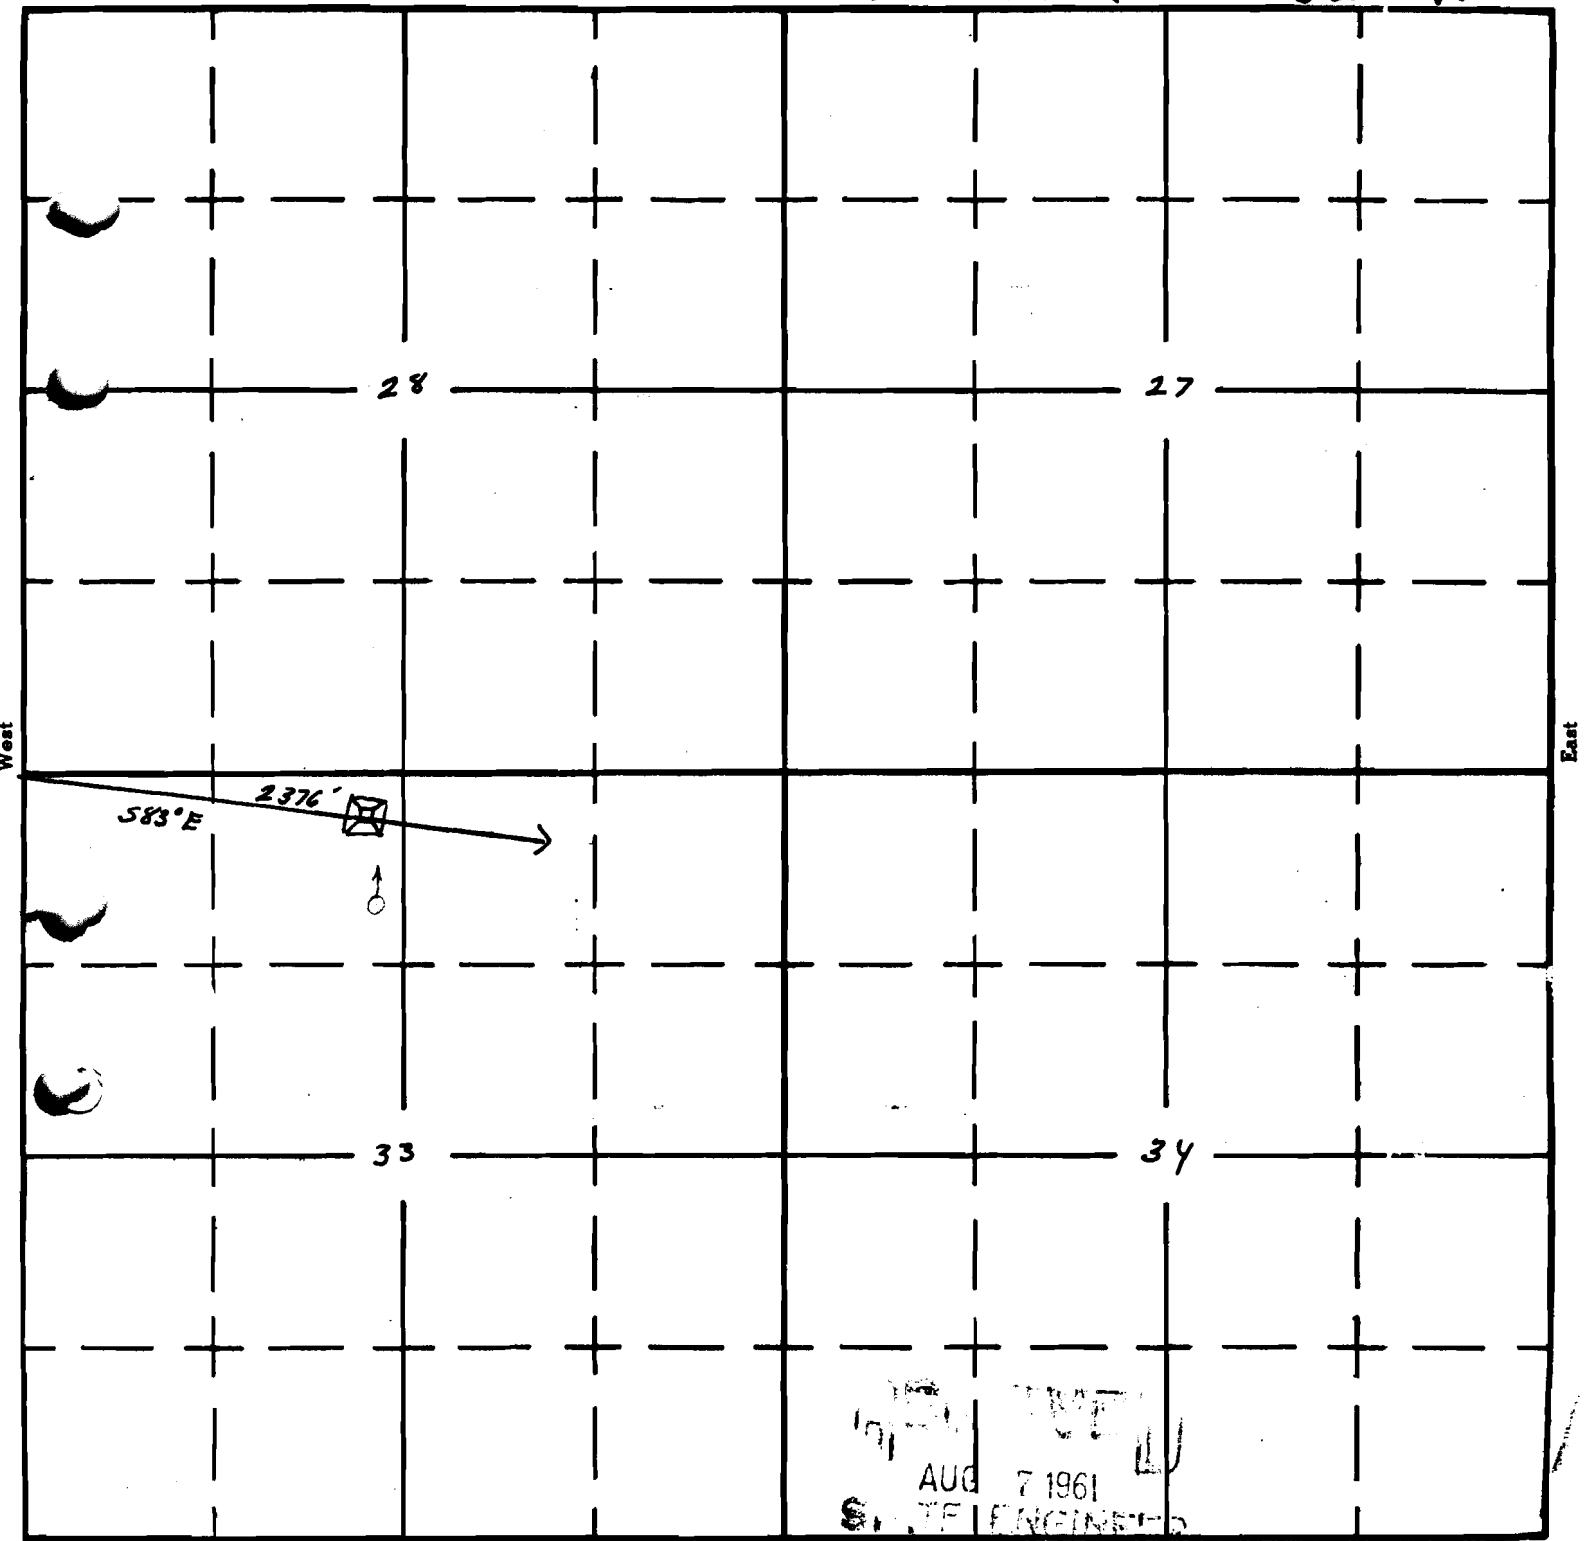

Rock Camp Draw 7 1/2' quad

South

RECEIVED  
AUG 7 1961  
STATE ENGINEER  
OREGON

APPLICATION No. R-36171  
PERMIT No. R-3571