

UNITED STATES
DEPARTMENT OF THE INTERIOR
BUREAU OF LAND MANAGEMENT

SECTION


28

Oregon State Water Filings

~~NE 1/4 SW 1/4~~
NW 1/4 NE 1/4

TOWNSHIP 39S, RANGE 30E, W. M.

Tied-in with aerial photos & O.S.H.D. Quad Maps

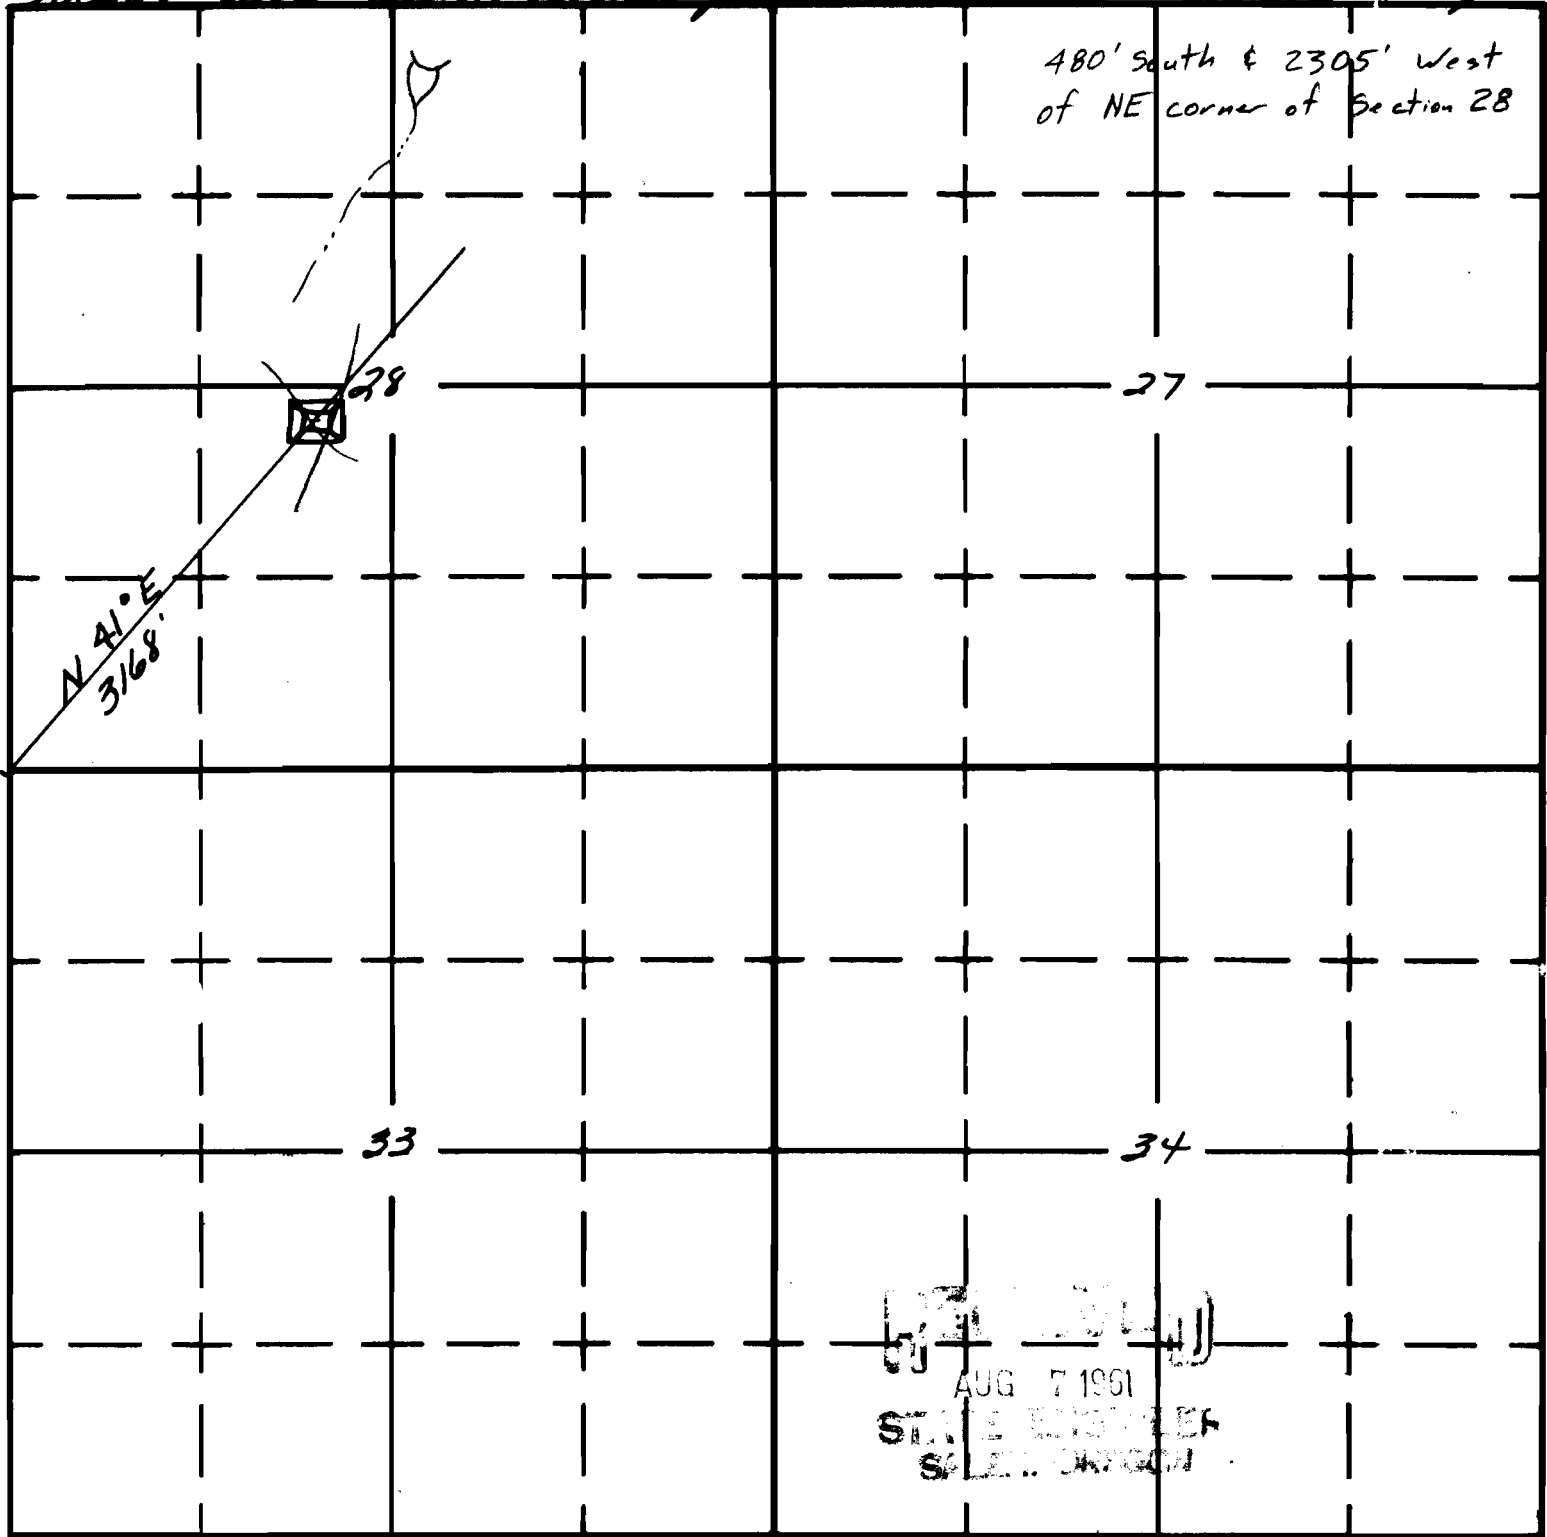

Acty Mtn. N.W. 7 1/2' quad

APPLICATION No. **R-36323**

PERMIT No. **R-3620**