

UNITED STATES
DEPARTMENT OF THE INTERIOR
BUREAU OF LAND MANAGEMENT

SECTION


25

Oregon State Water Filings

NE 1/4 SW 1/4

TOWNSHIP 30 S, RANGE 27E, W. M.

Tied in with aerial photo and O.S.H.D. Quad Maps.

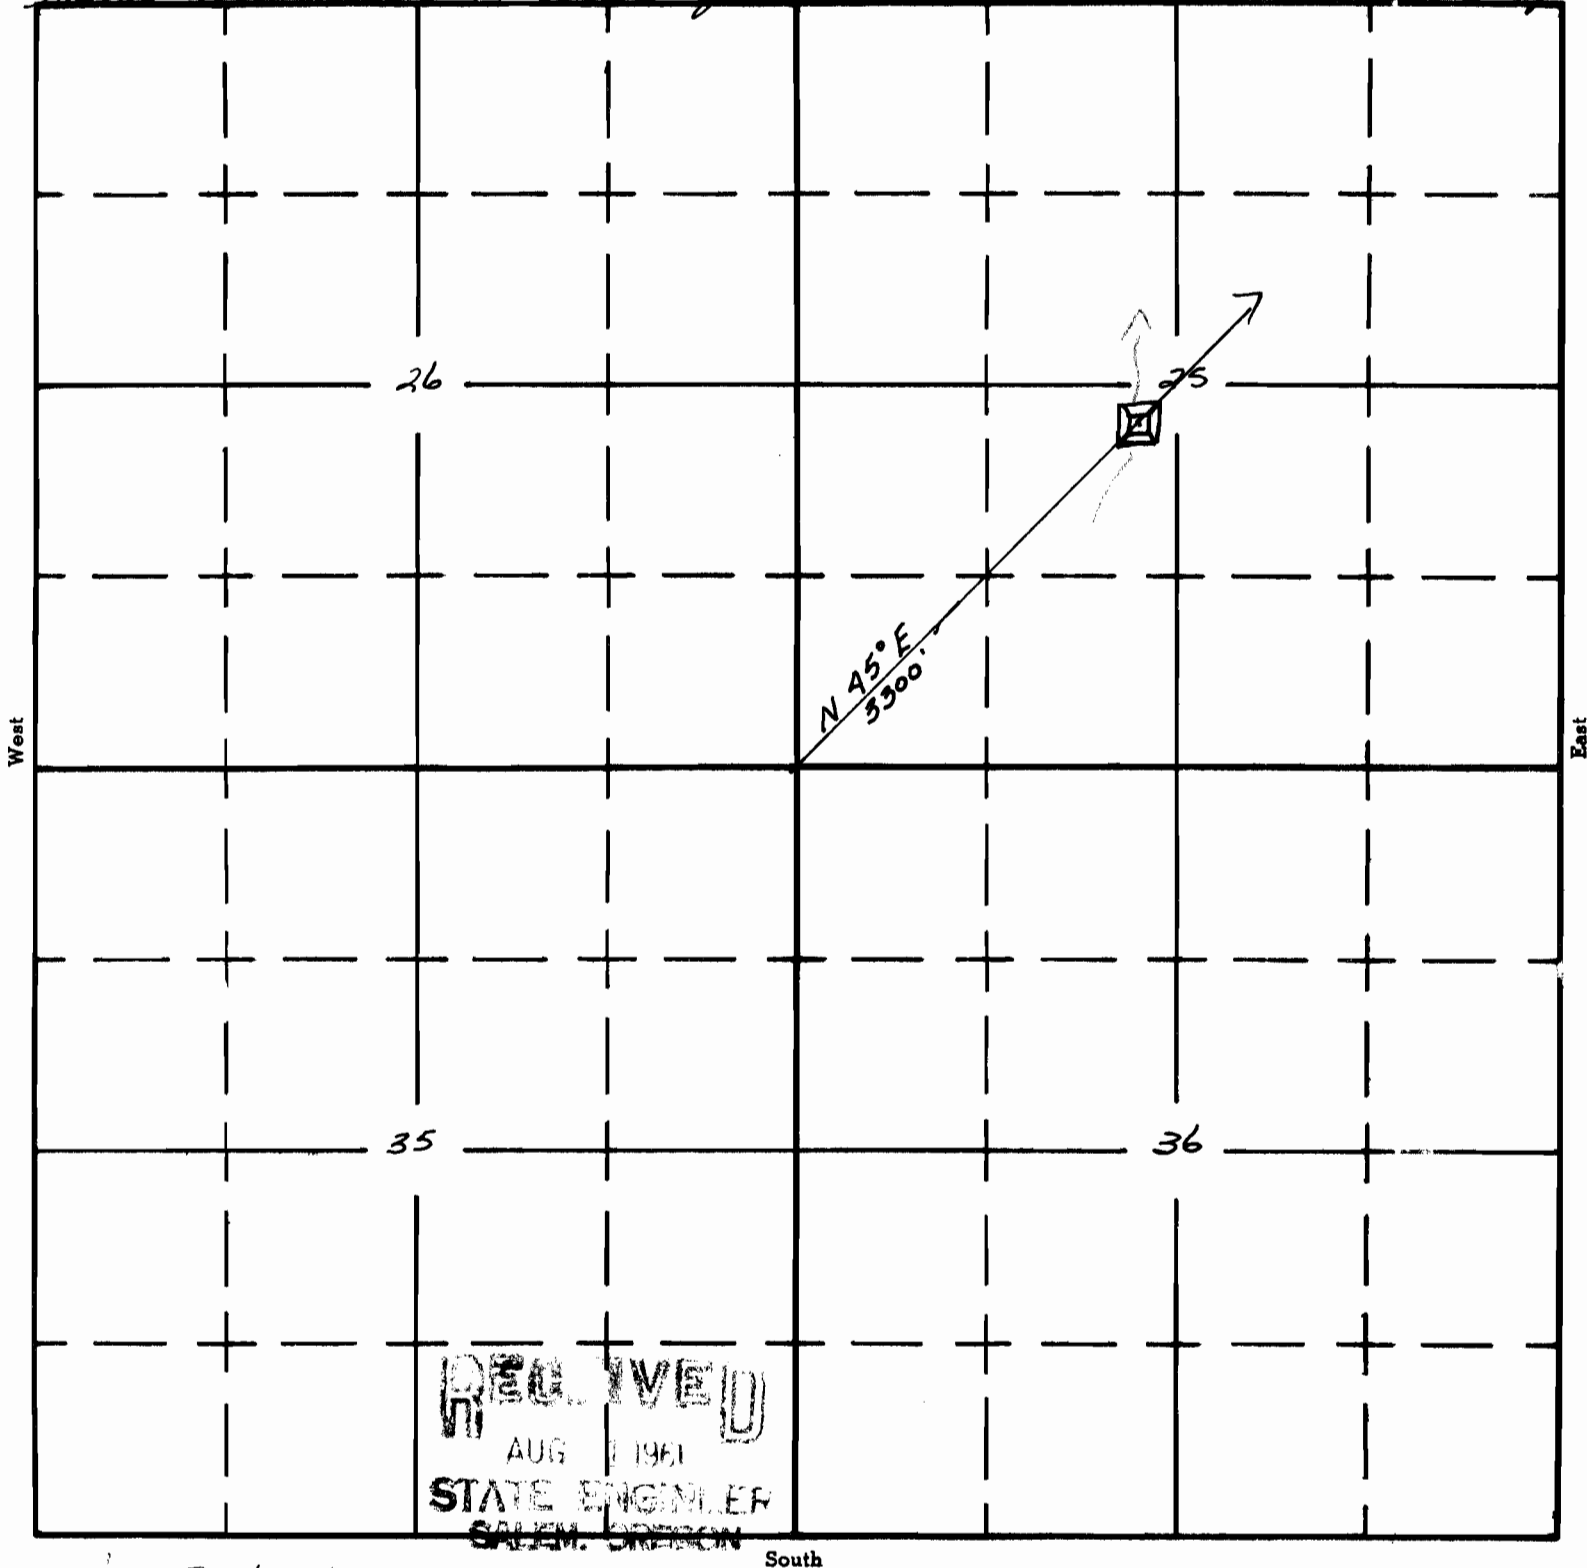

Balls Lake 7 1/2' quad

APPLICATION No. R-35929
PERMIT No. R-3708