

UNITED STATES
DEPARTMENT OF THE INTERIOR
BUREAU OF LAND MANAGEMENT


SECTION
35

Oregon State Water Filings

~~SW~~¹/₄ NE¹/₄

TOWNSHIP 30 S, RANGE 27 E, W. M.

Tied in with aerial photos and O.S.H.D. Quad Maps

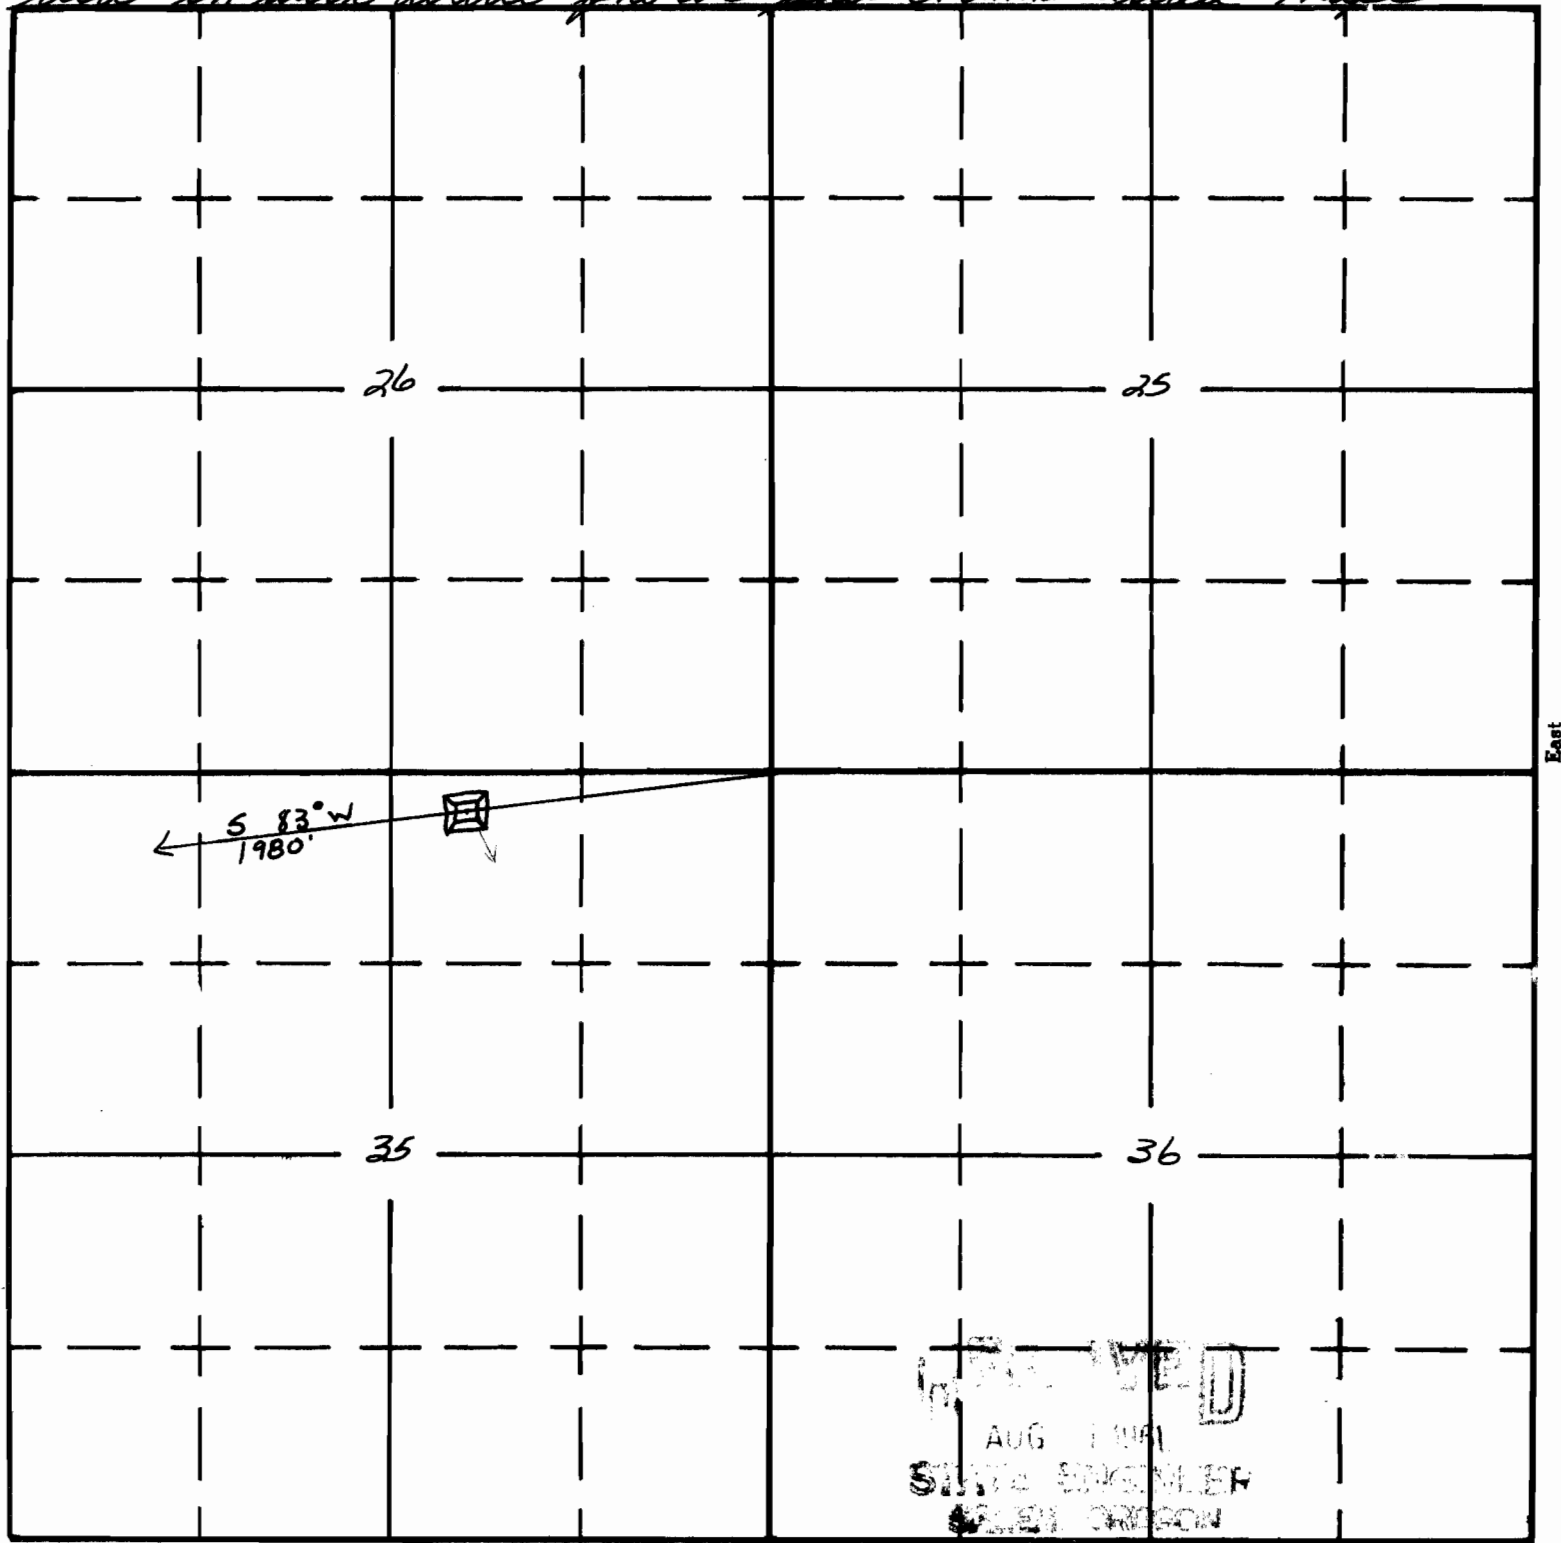

Balls Lake 7 1/2' quad