

Form A1-187
March 1961

UNITED STATES
DEPARTMENT OF THE INTERIOR
BUREAU OF LAND MANAGEMENT


SECTION
20

Oregon State Water Filings

SE 1/4 SW 1/4

TOWNSHIP 29S, RANGE 28E, W. M.

Tied-in with aerial photo and O.S.H.D. Quad Maps

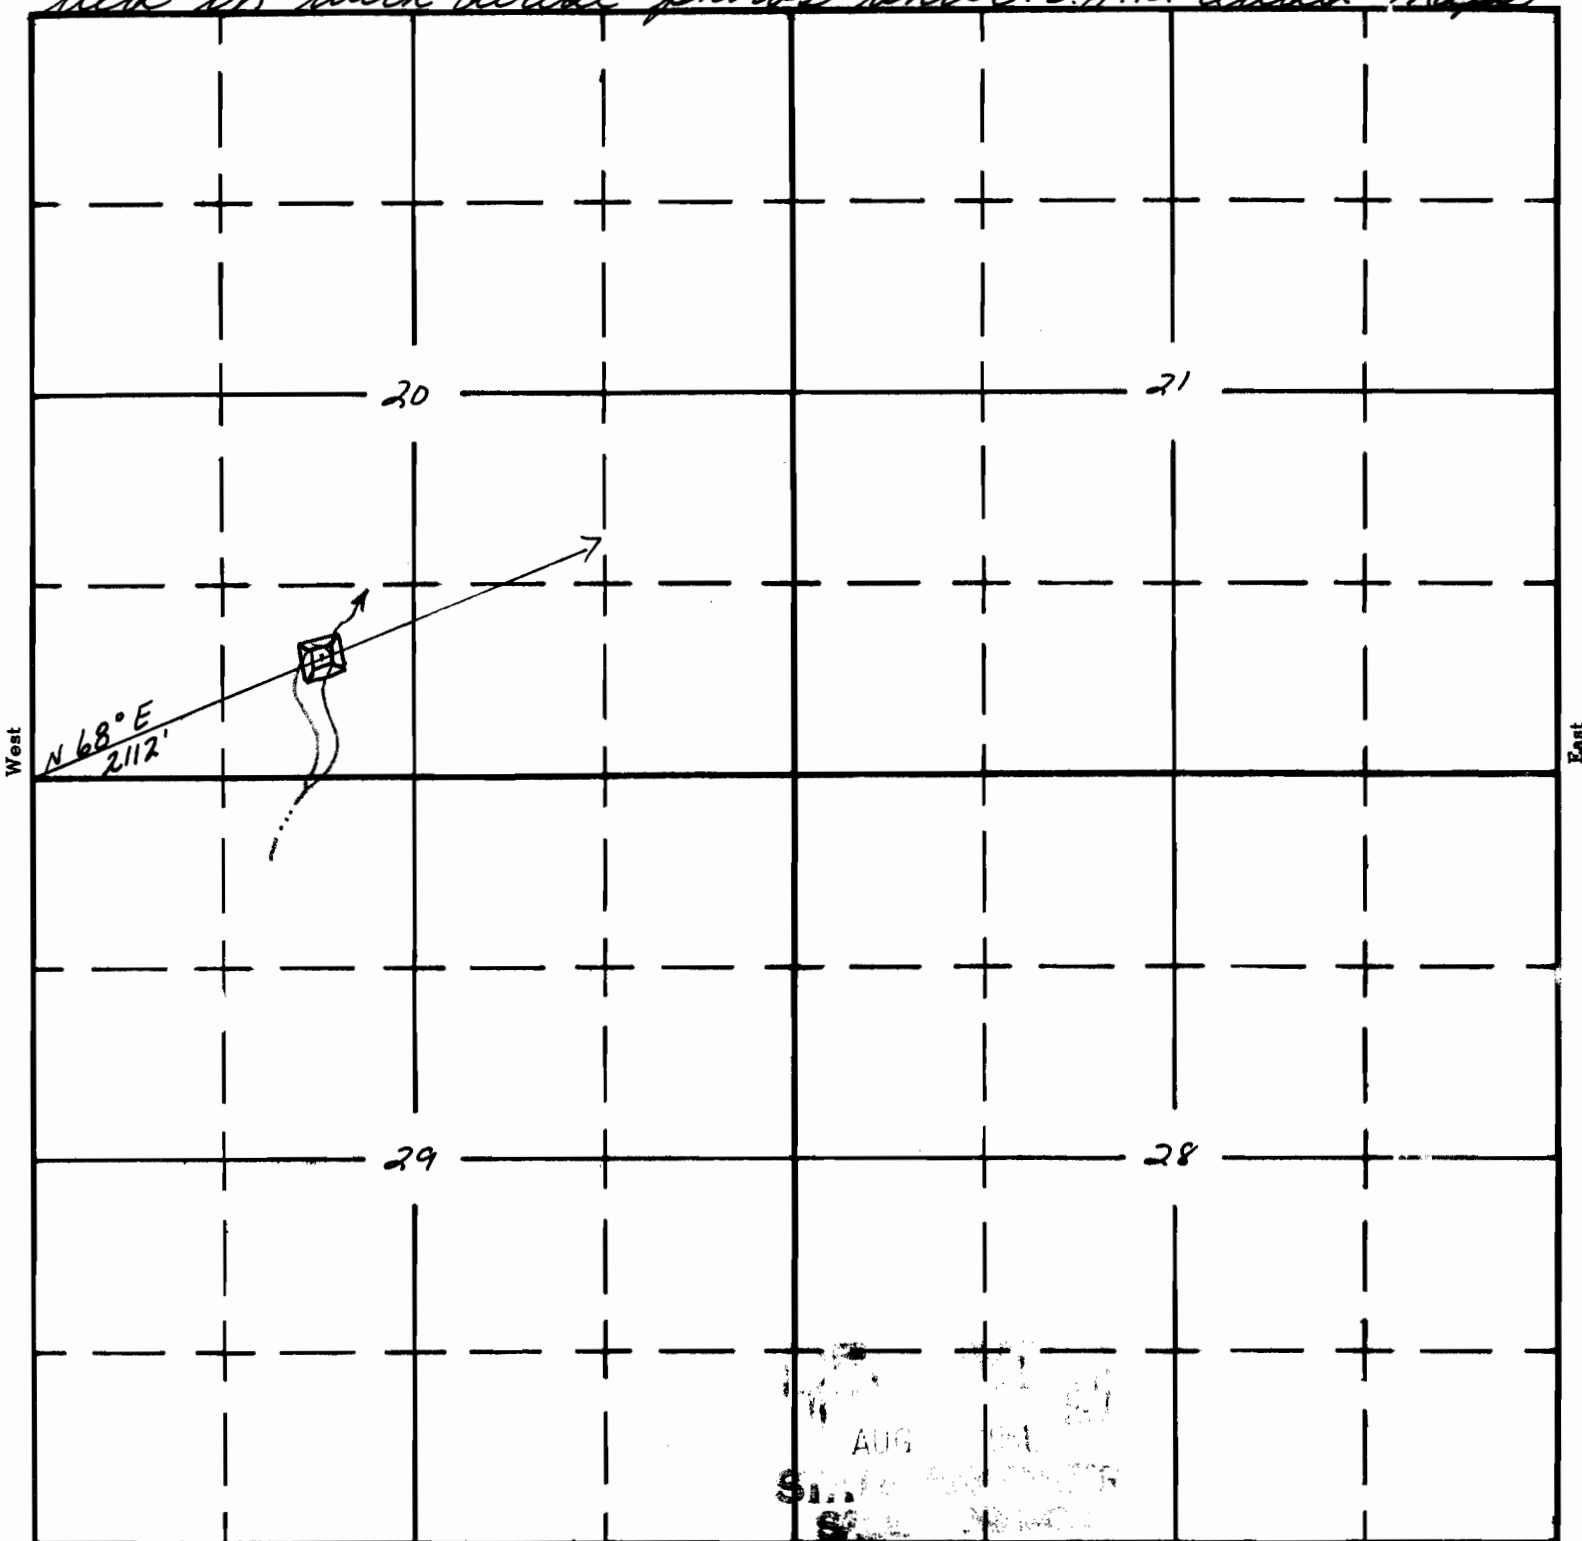

Flybee Lake 7 1/2' quad

South

APPLICATION No. **R-35942**
PERMIT No. **R-3720**