

Form A1-187
March 1961


UNITED STATES
DEPARTMENT OF THE INTERIOR
BUREAU OF LAND MANAGEMENT

SECTION
24

Oregon State Water Filings

SW 1/4 SW 1/4 TOWNSHIP 31S, RANGE 25E, W. M.

Tied in with aerial photos and O.S.H.P. Quad Maps

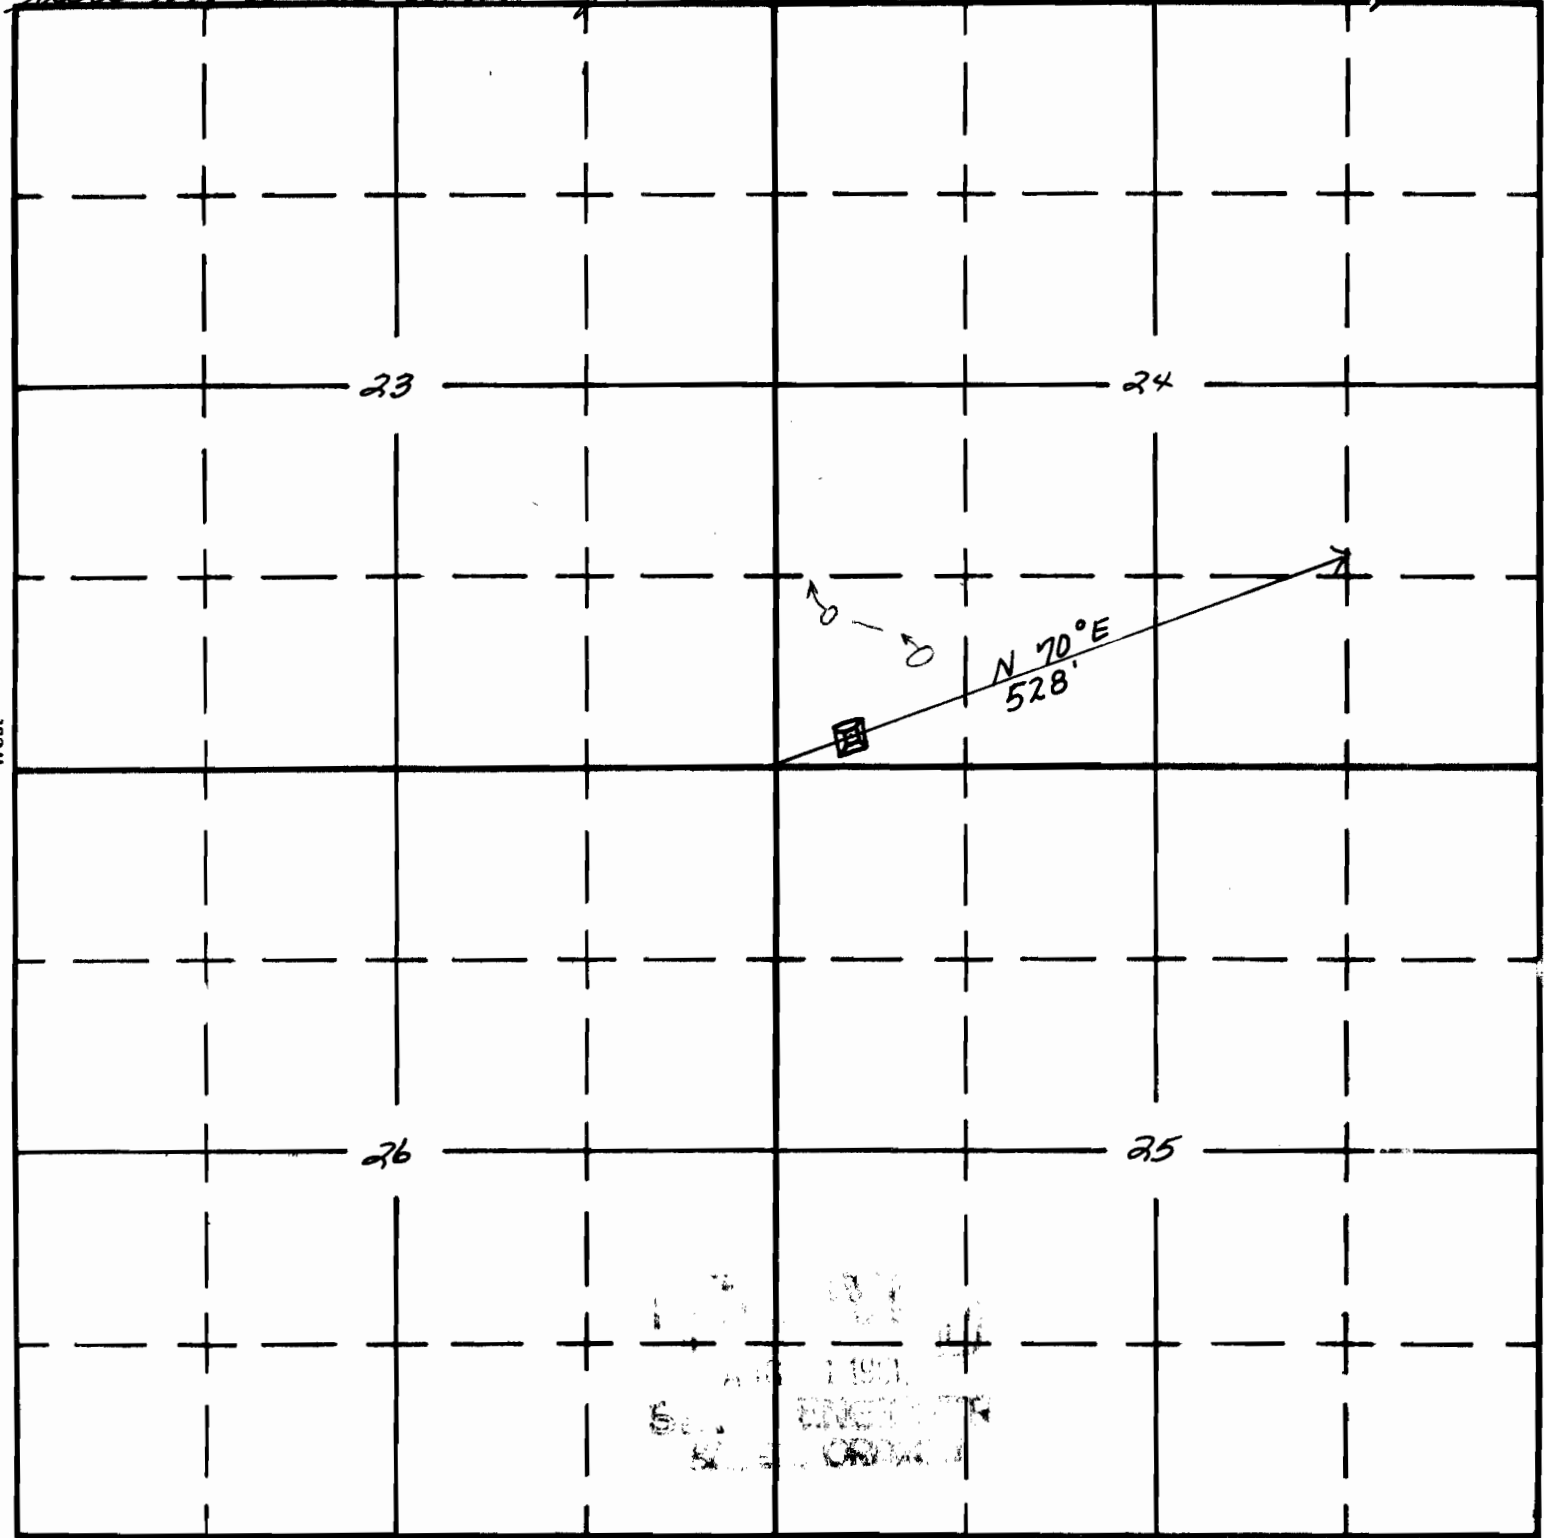

Corporation Rim $7\frac{1}{2}'$ quad

APPLICATION No. **R-35955**
PERMIT No. **R-3732**