

Form A1-187
March 1961

UNITED STATES
DEPARTMENT OF THE INTERIOR
BUREAU OF LAND MANAGEMENT

SECTION


22

SW 1/4 SE 1/4

Oregon State Water Filings

TOWNSHIP 31S, RANGE 26E, W. M.

North *Tied in with aerial photo and OSND Quad maps*

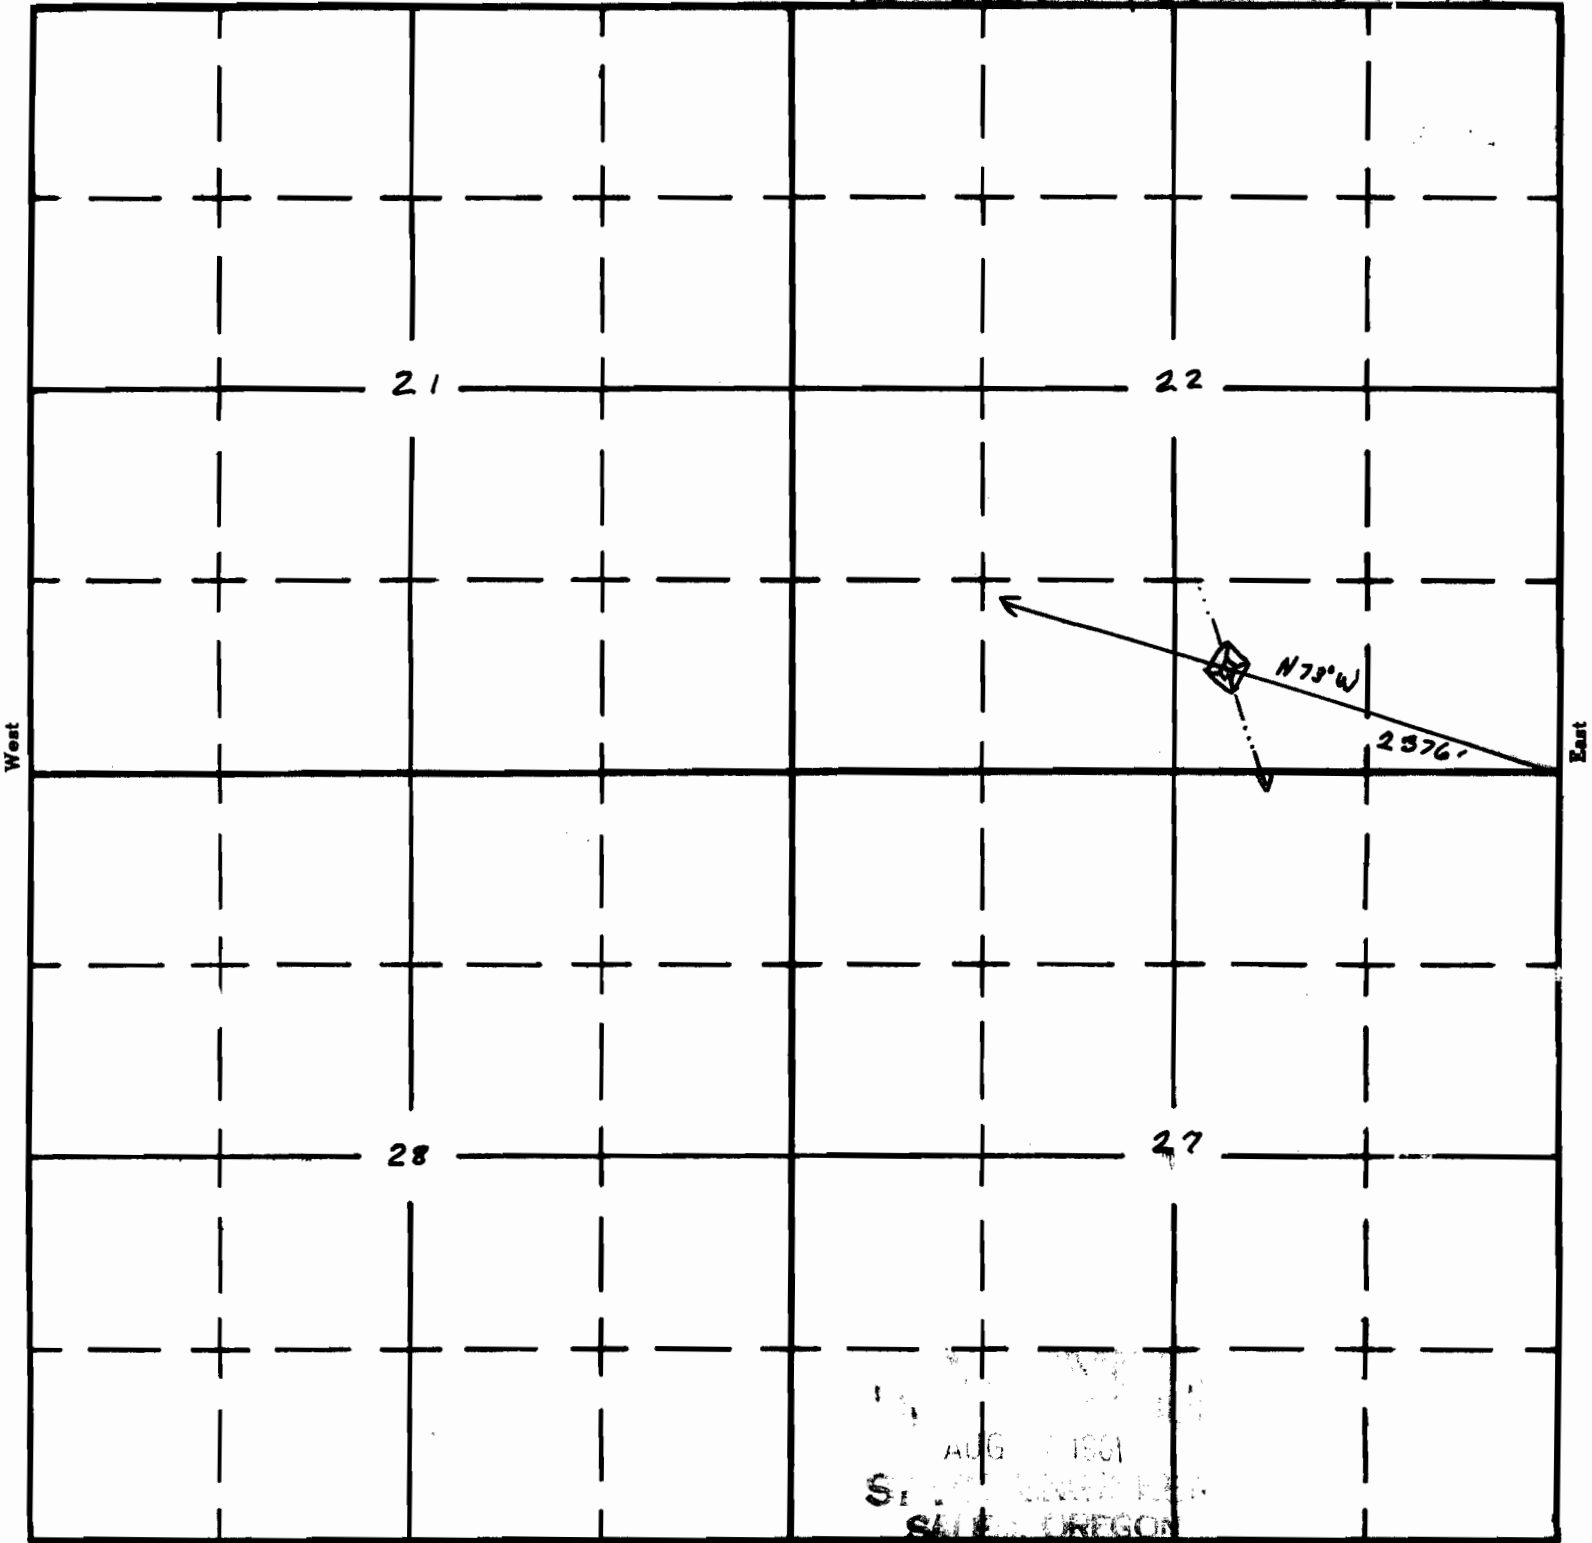

Corporation Rim 7 1/2' quad

APPLICATION No. R-36182

PERMIT No. 7044