

Form A1-187
March 1961


UNITED STATES
DEPARTMENT OF THE INTERIOR
BUREAU OF LAND MANAGEMENT

SECTION 9
NE 1/4 NW 1/4

Oregon State Water Filings

TOWNSHIP 31S, RANGE 26E, W. M.

DEC 1961
STATE
CATTLE

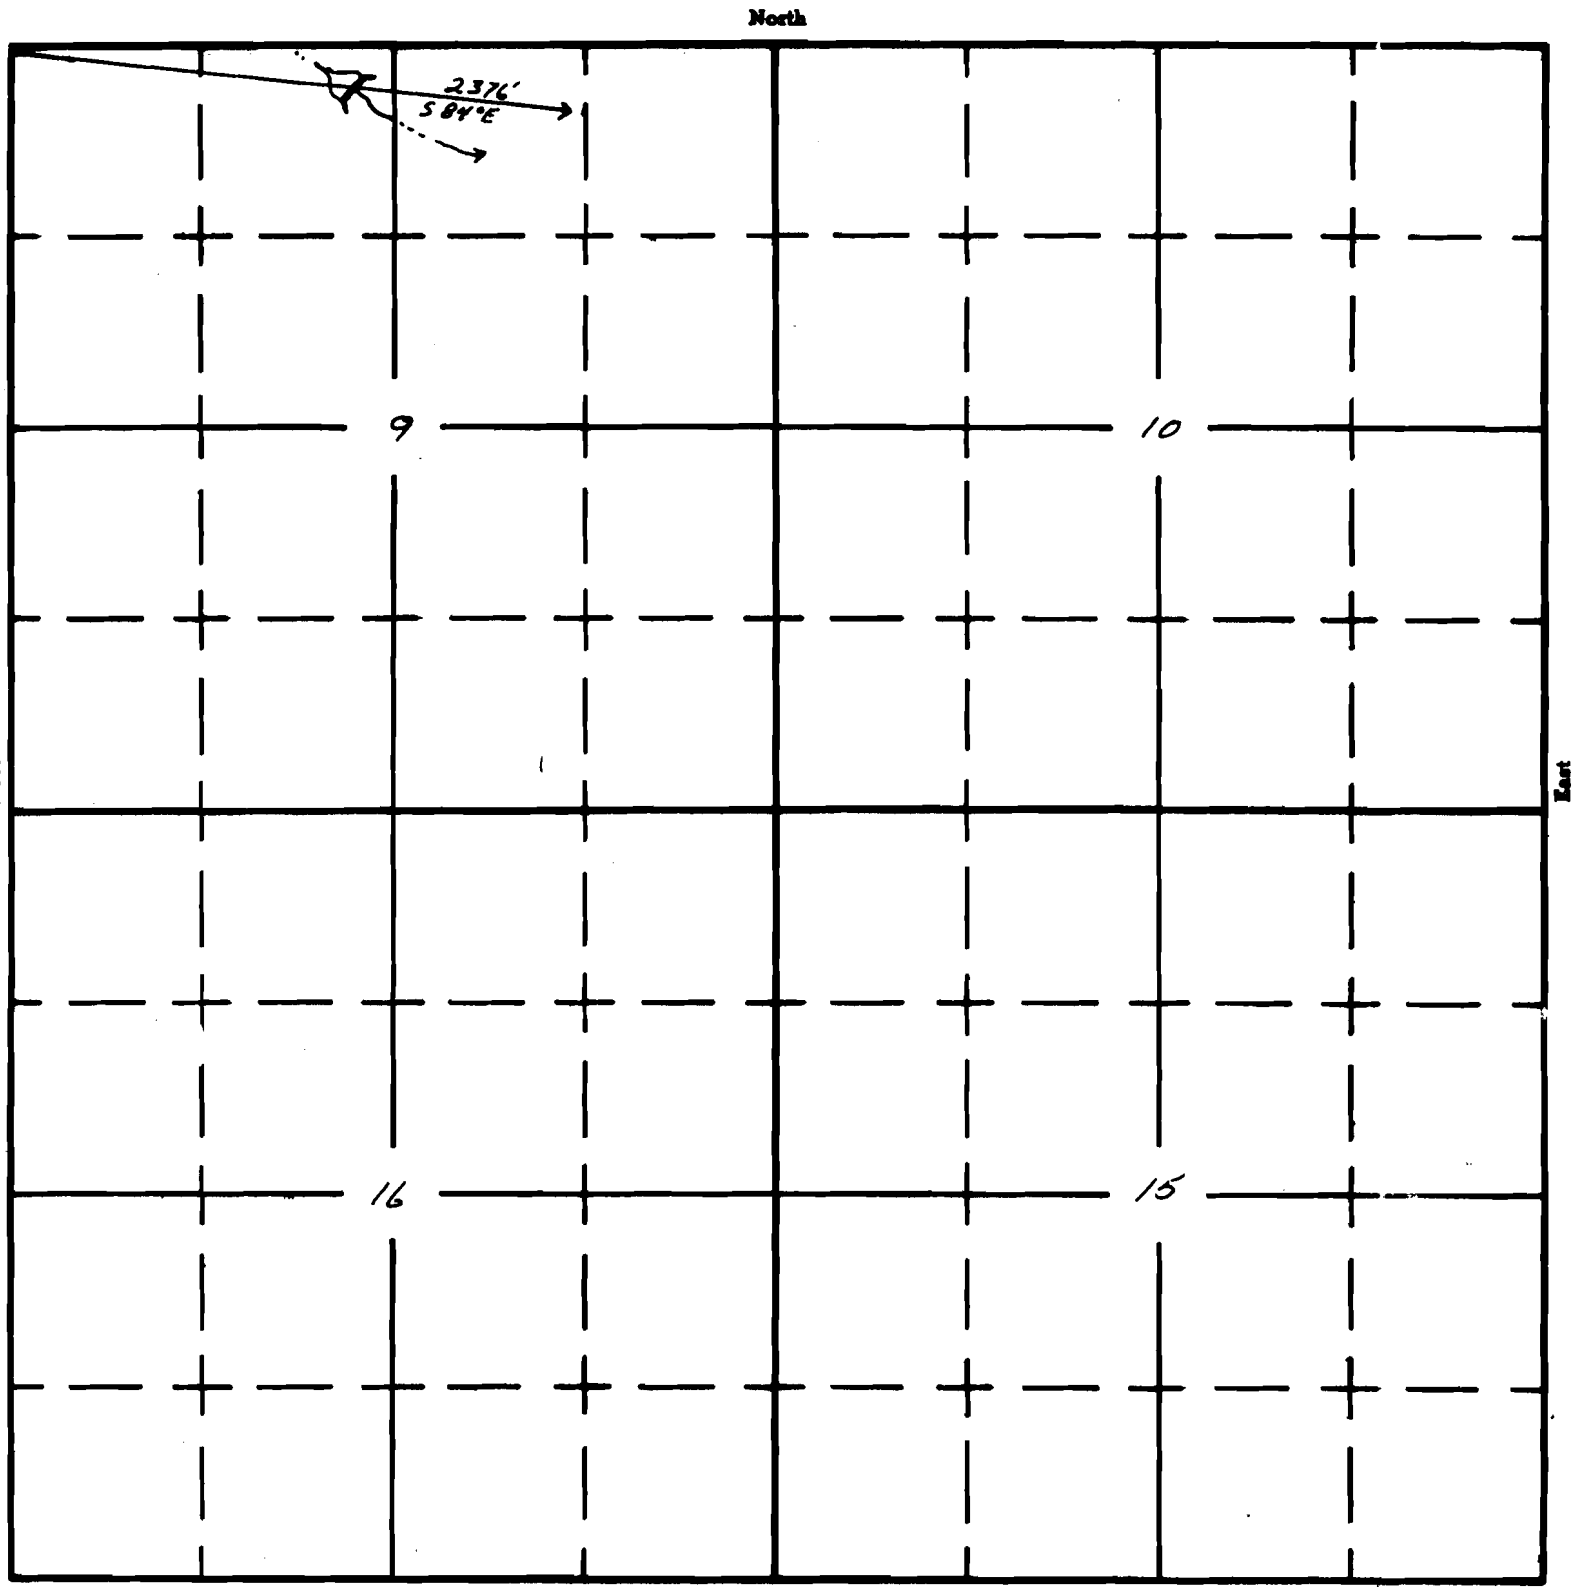

Roosevelt Wh.
91-160-164

Red Bank Lakes quad

APPLICATION No. R-36294
PERMIT NR 7090