


# T. 34 S., R. 1 W., W.M.

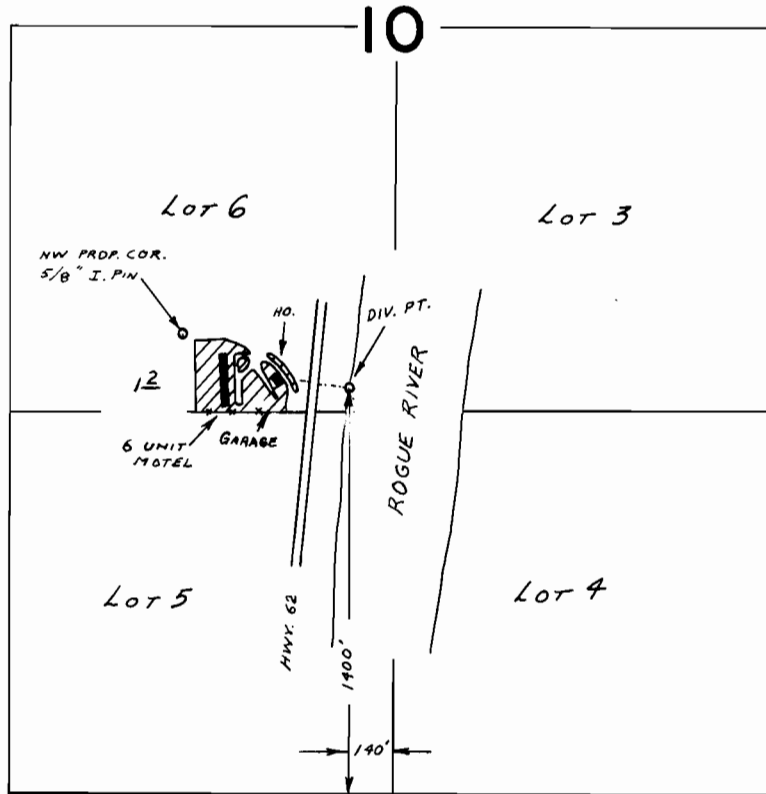

SCALE : 1" = 660 FT.

## FINAL PROOF SURVEY UNDER

Application No. 57278 Permit No. 43115  
IN NAME OF

Mr. Robinson or Margaret Seenech

Surveyed OCT. 20 1978, by B. SUND