


T. 37 S., R. 7 W., W.M.

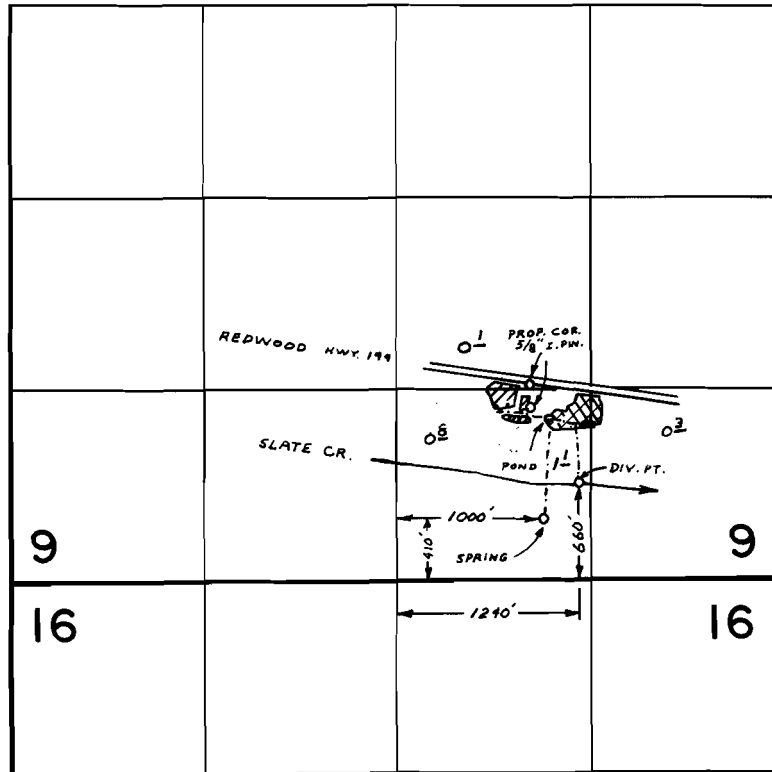


SLATE CREEK


SPRING

FINAL PROOF SURVEY UNDER

Application No. 50057 Permit No. 37624
IN NAME OF

RUSSEL J. HUDSON

Surveyed JUL. 27 1978, by B. SUND