


R-2601
51384

BUREAU OF LAND MANAGEMENT NOTCH CORRAL WATERHOLE RECONSTRUCTION

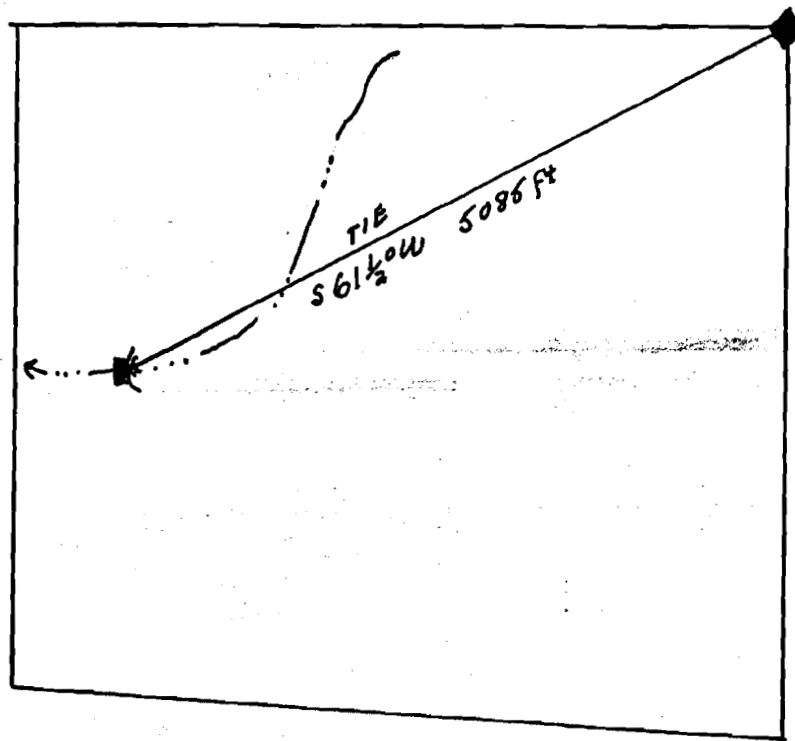

T41S; R14 1/2 E; SEC. 22; WM

PROJECT -

INTERMITTENT STREAM ~~~~~>

FOUND SURVEY CORNERS ♦

RECEIVED
MAR 10 1960
STATE ENGINEER
SALEM, OREGON

Gerber Reservoir 15' quad

Application No. R-33723
Permit No. R-2601

lam
2/60