

✓ R-3704
.51388

UNITED STATES
DEPARTMENT OF THE INTERIOR
BUREAU OF LAND MANAGEMENT


SECTION

Oregon State Water Filings

TOWNSHIP 39S, RANGE 13E, W. M.

North

Miller Ck = Misc.

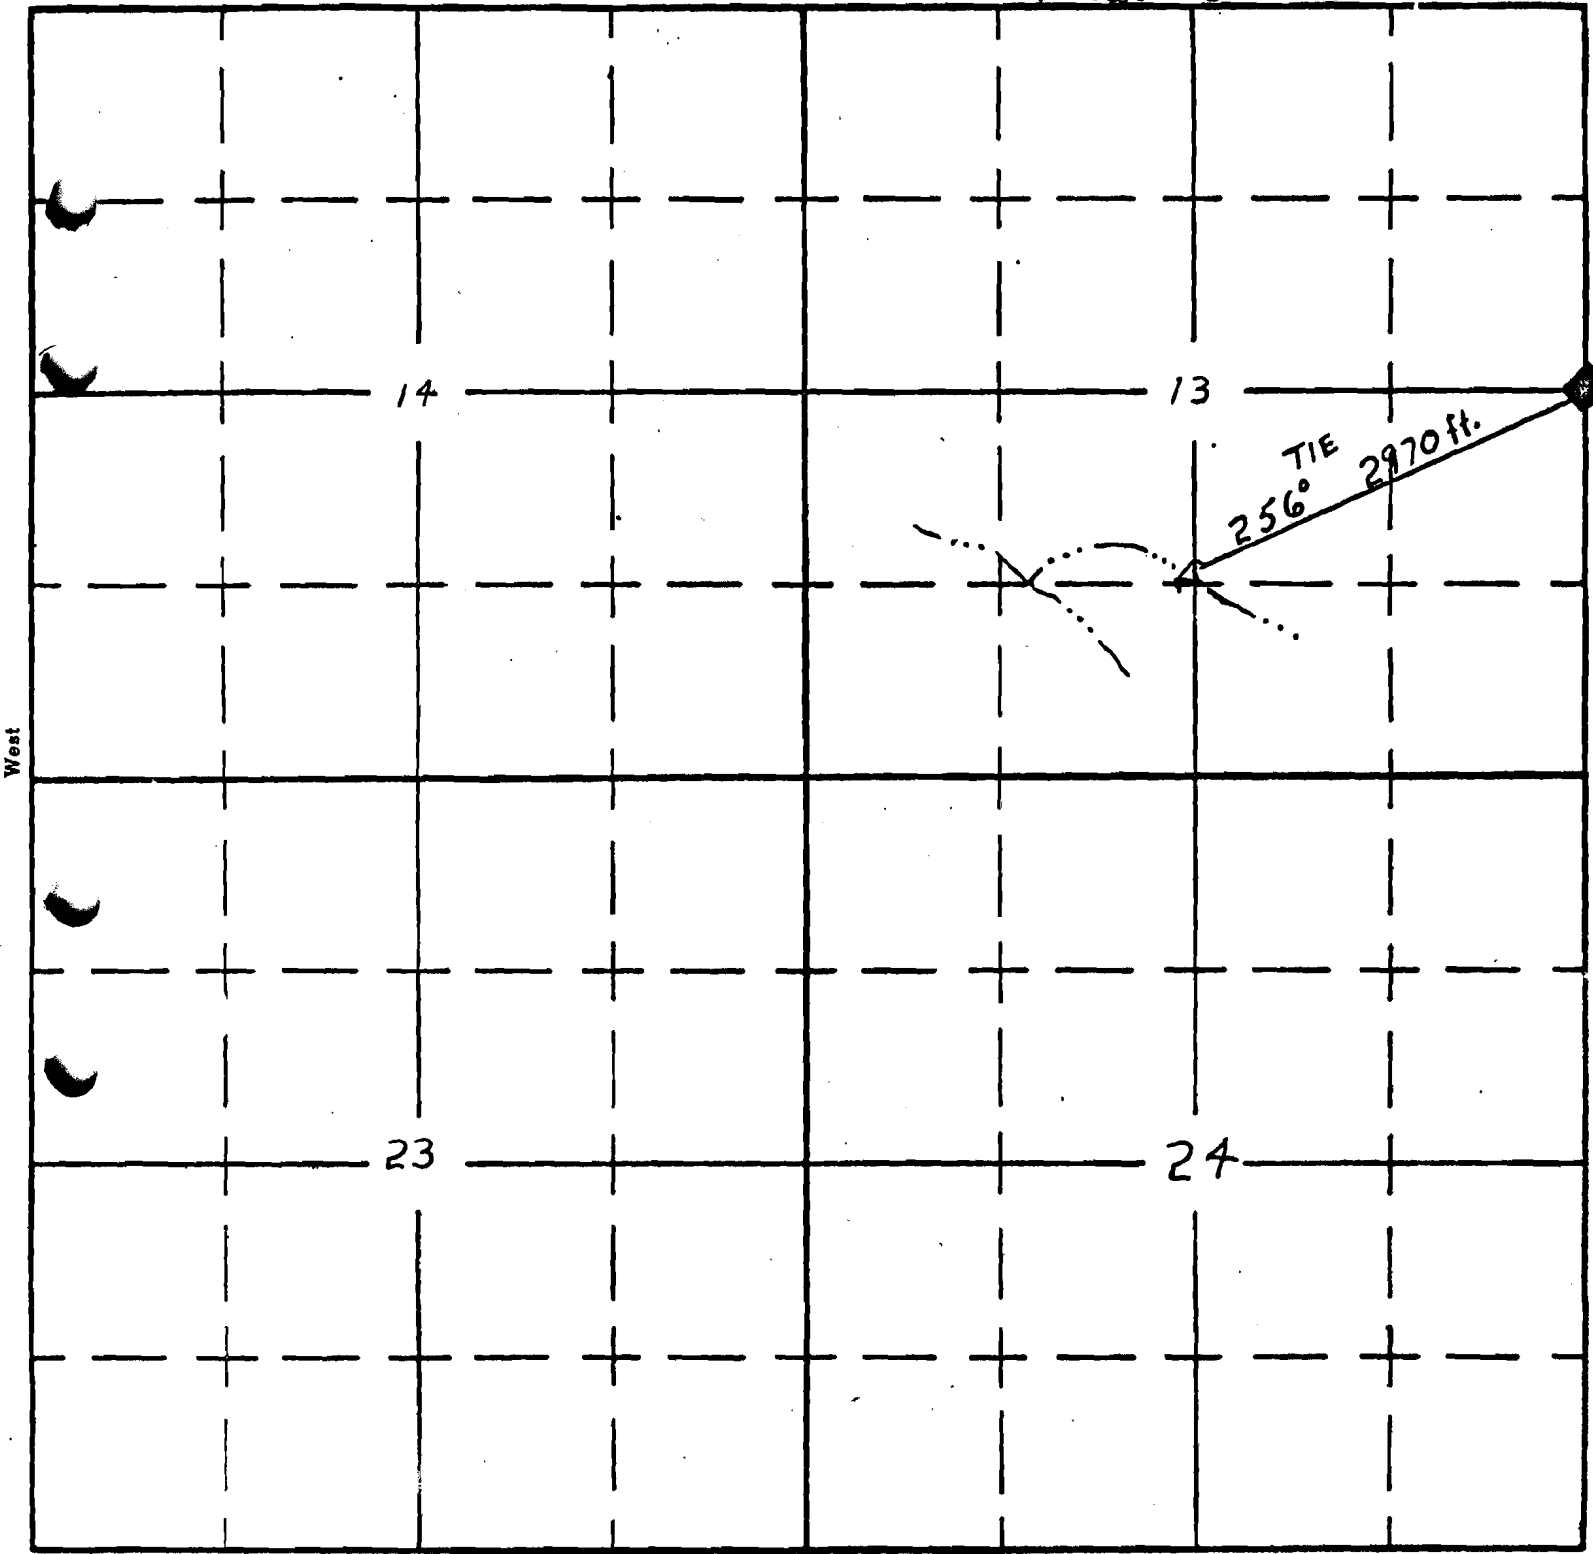

Legend
◆ - Known Survey Corner
⊕ - Reservoir

APPLICATION No. R-3384

PERMIT No. R-370