

m-A1-187
arch 1961

UNITED STATES
DEPARTMENT OF THE INTERIOR
BUREAU OF LAND MANAGEMENT

51387
51389


SECTION
9

Oregon State Water Filings

NE $\frac{1}{4}$ NW $\frac{1}{4}$

TOWNSHIP 39S, RANGE 11 $\frac{1}{2}$ E, W. M.

Grid-in with aerial photos & O.S.H.D. Quad Maps.

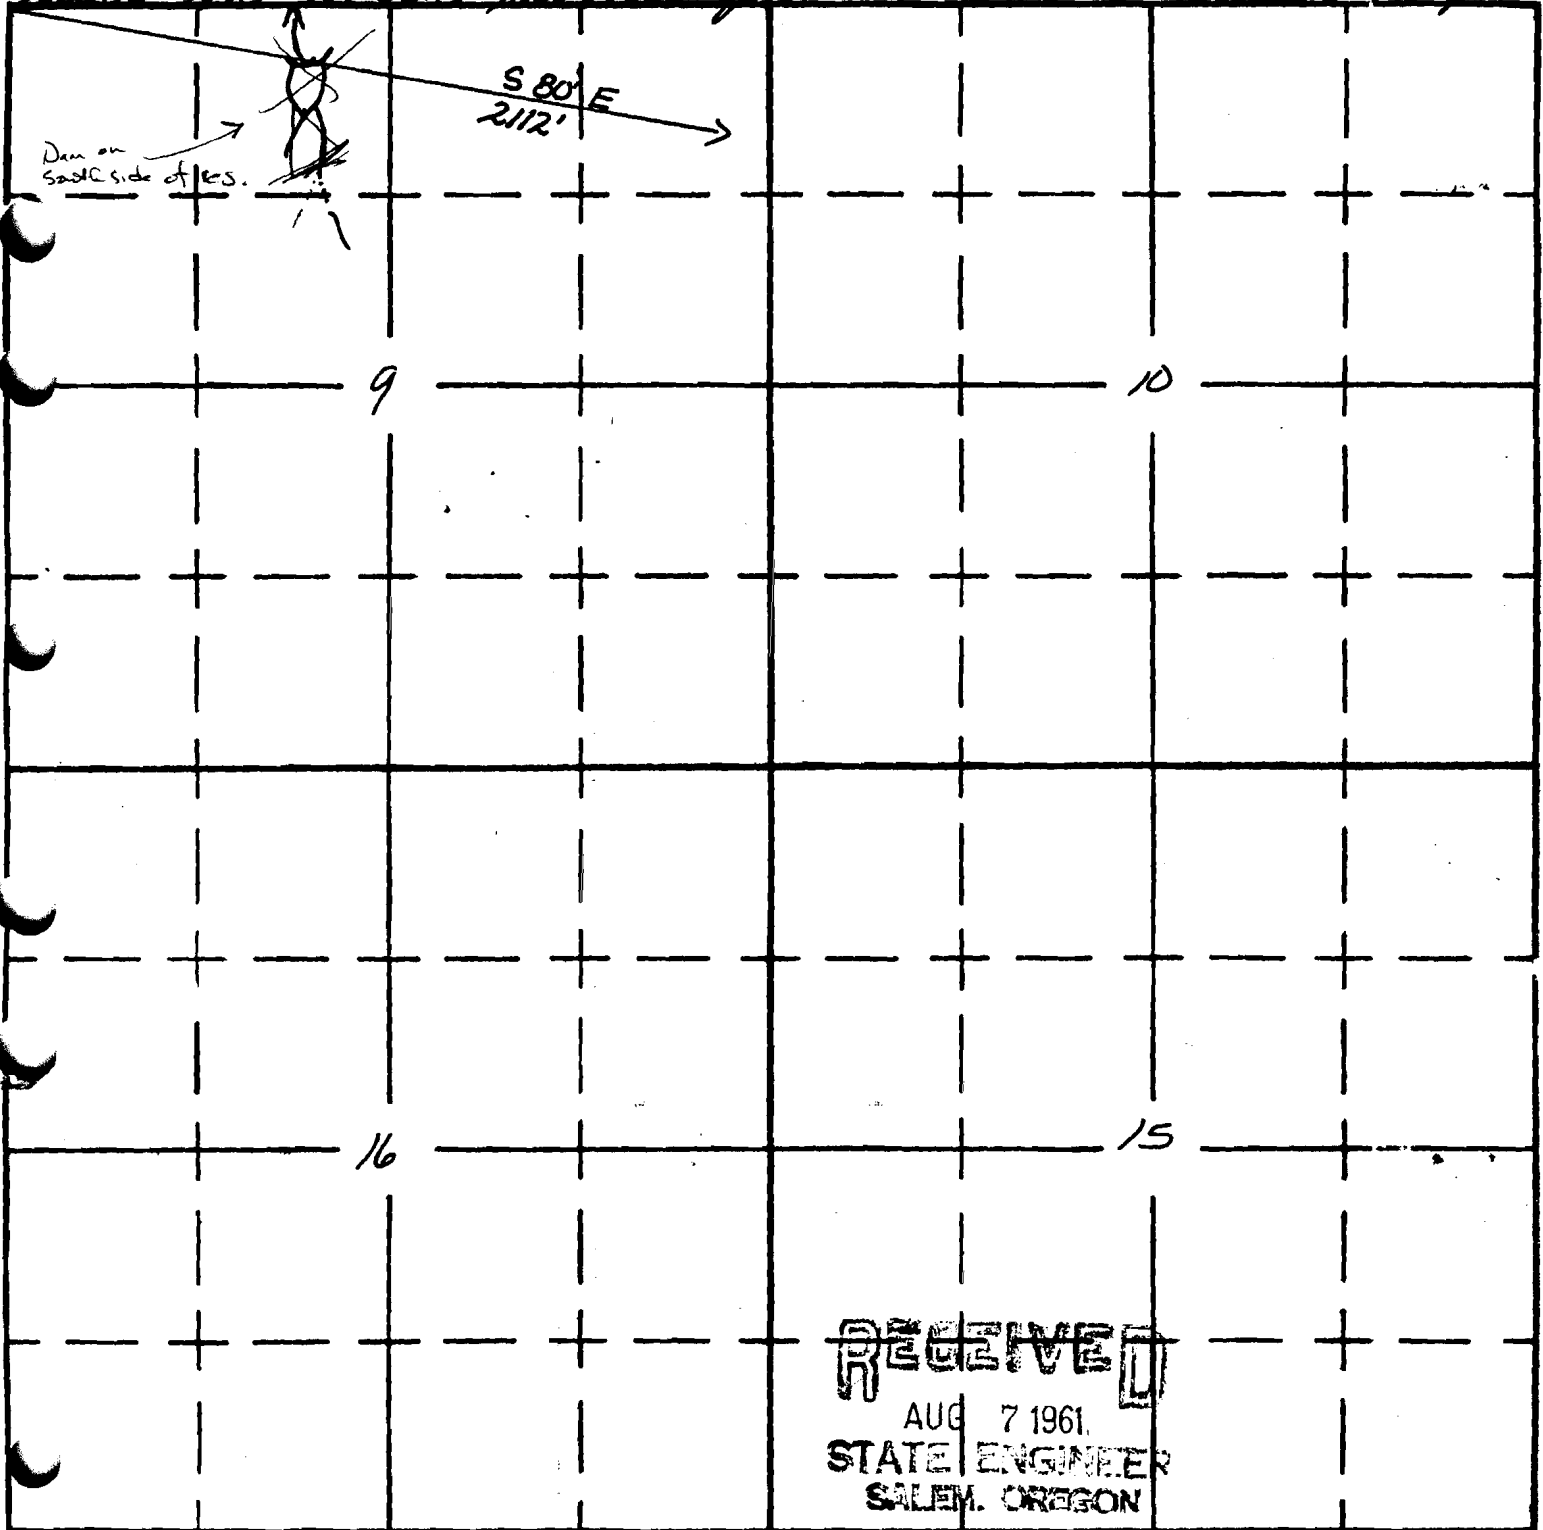

South

Merrill 15' quad

APPLICATION No. R-3612

PERMIT No. R-4219