

1967
1961

UNITED STATES
DEPARTMENT OF THE INTERIOR
BUREAU OF LAND MANAGEMENT

R-6885
51390
RECEIVED
SEP 8 1961
STATE ENGINEER
SALEM, OREGON

SECTION
23

Oregon State Water Filings

SE 1/4 SW 1/4


TOWNSHIP 38 S, RANGE 11 E, W. M.

North

*Tied-in with aerial photos
& O.S.H.D. Quad Maps.*

23

24

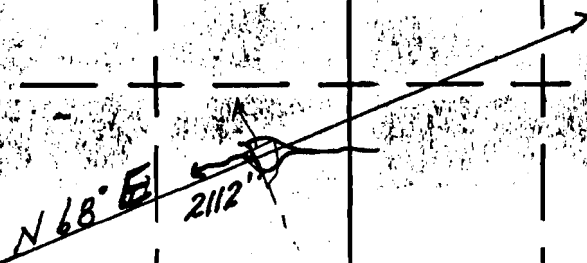

26

25

Beatty 15' quad

RECEIVED
JUL 21 1961
STATE ENGINEER
SALEM, OREGON

South

APPLICATION No. R-35300
PERMIT No. H-1000