

Form AI-187
March 1961

UNITED STATES
DEPARTMENT OF THE INTERIOR
BUREAU OF LAND MANAGEMENT

R-7131
51391

RECEIVED

APR 11 1978

WATER RESOURCES DEPT.
SALEM, OREGON

SECTION


15

Oregon State Water Filings

SE $\frac{1}{4}$ SE $\frac{1}{4}$

TOWNSHIP 39 S, RANGE 11 $\frac{1}{2}$ E, W. M.

Tied in with aerial photos & O.S.H.D. Quad Maps

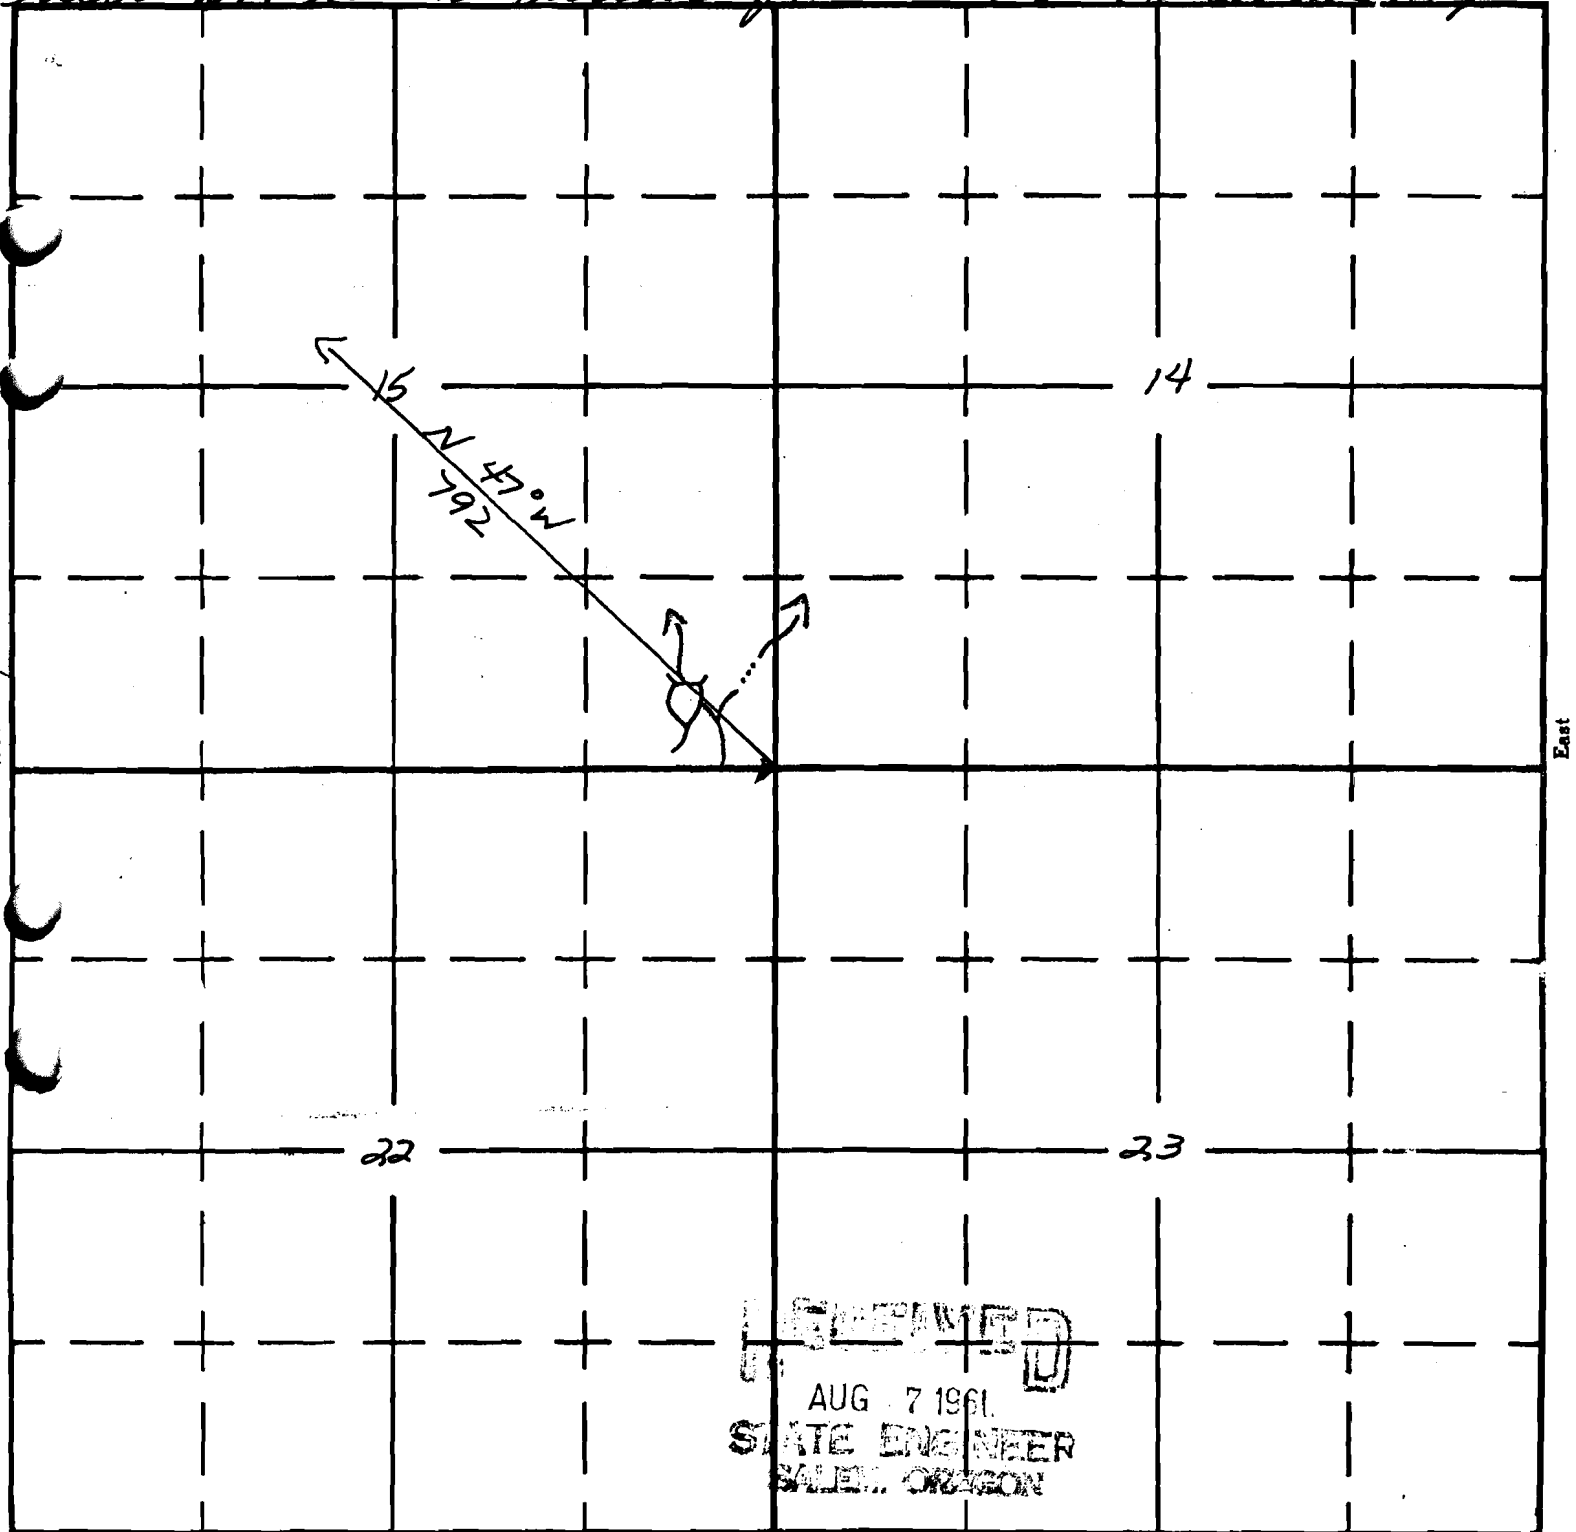

Merrill 15' quad

APPLICATION No. R-36128
PERMIT No. R 7131