

R-7132
51392

Form AI-187
March 1961

UNITED STATES
DEPARTMENT OF THE INTERIOR
BUREAU OF LAND MANAGEMENT

RECEIVED

APR 11 1978

WATER RESOURCES DEPT.
SALEM, OREGON


SECTION 9

Oregon State Water Filings

~~SW 1/4 NW 1/4~~
~~NW 1/4 SW 1/4~~

TOWNSHIP 39S, RANGE 11 1/2 E, W. M.

Filed in with aerial photos and O.S.H.D. Quad Maps.

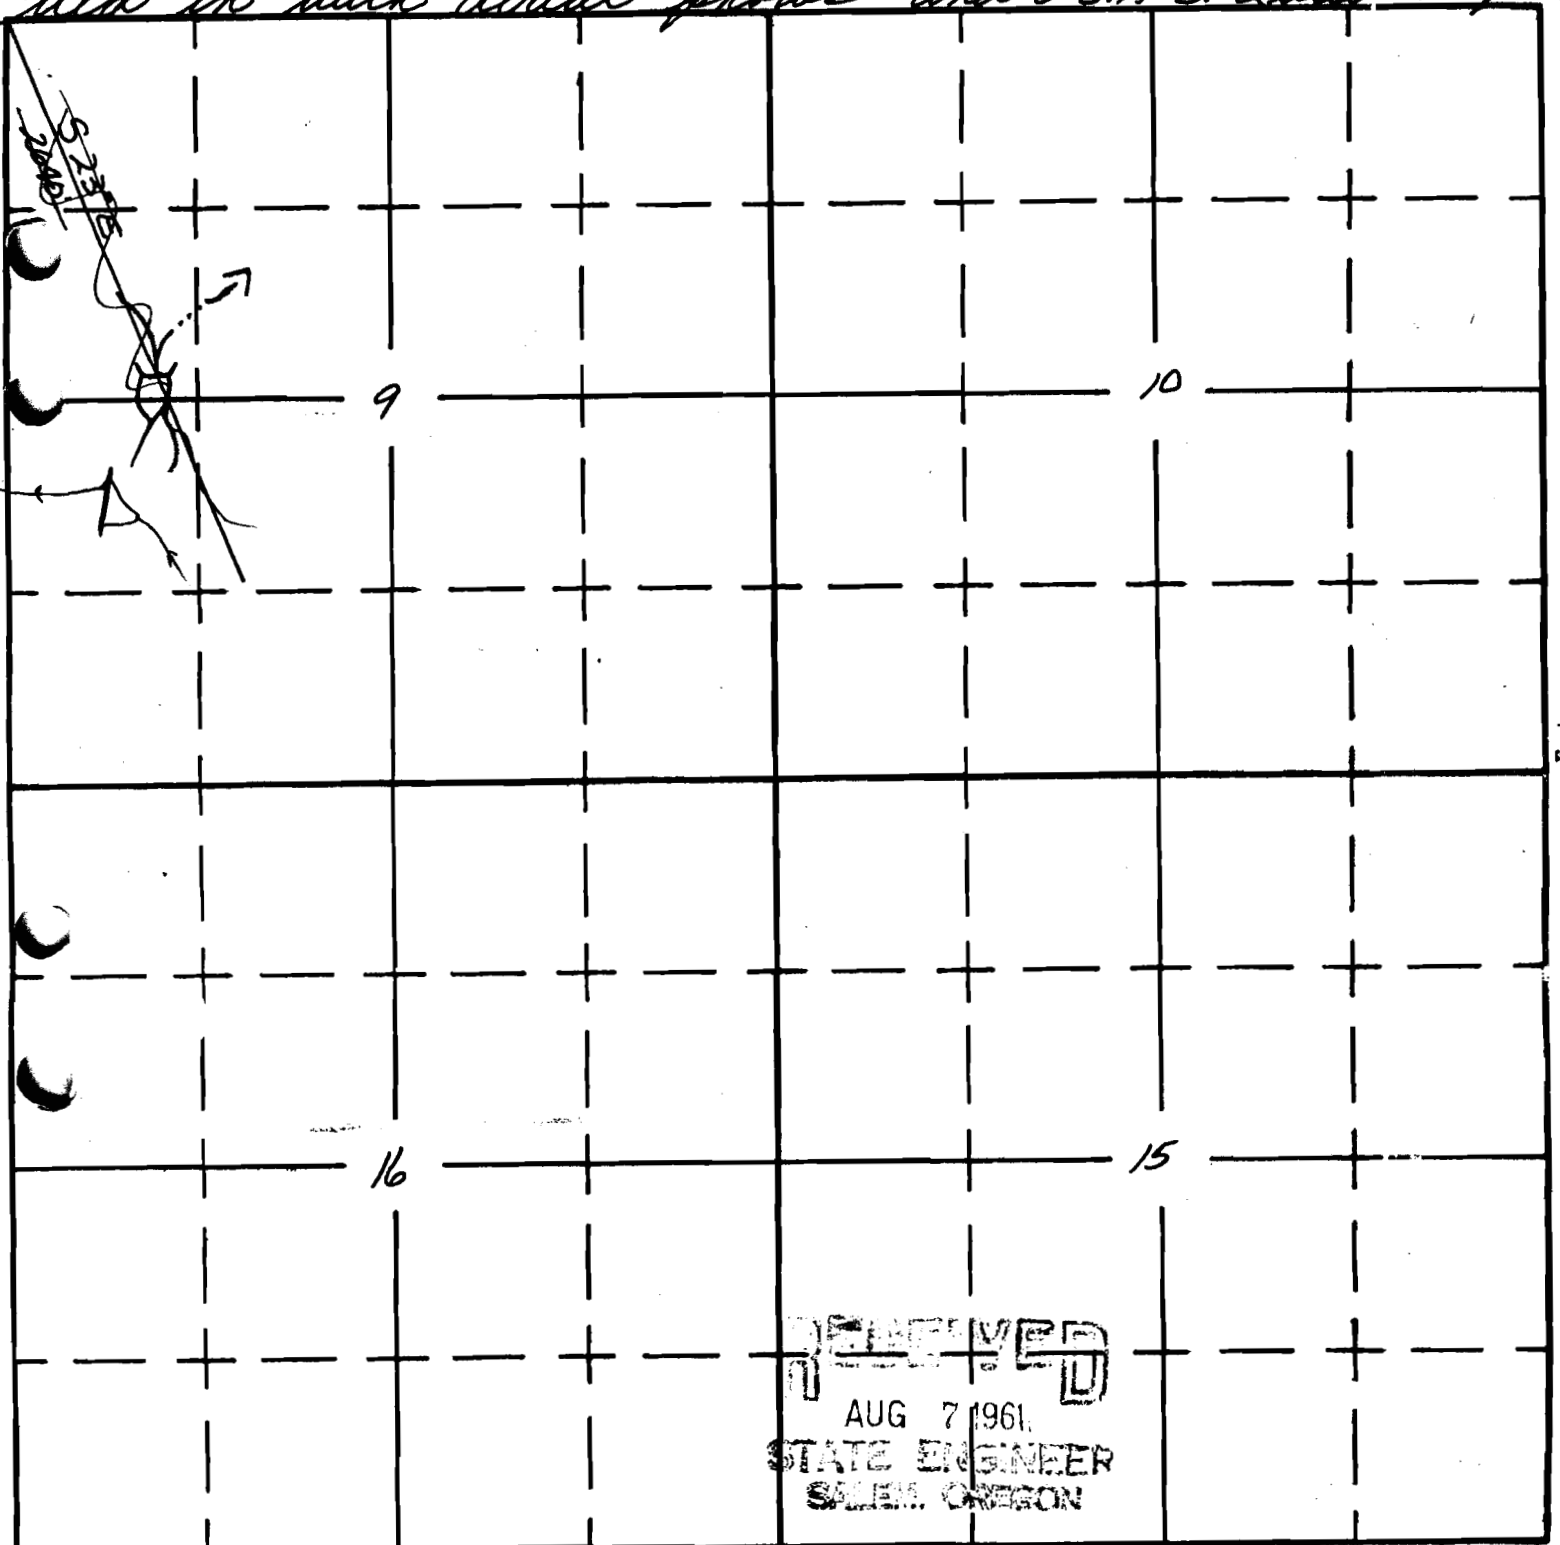

RECEIVED
AUG 7 1961
STATE ENGINEER
SALEM, OREGON

Merrill 15' quad

APPLICATION No. R-36129
PERMIT No. 7132