

Nov. 1965

DEPARTMENT OF THE INTERIOR
BUREAU OF LAND MANAGEMENT

P-7398
51394


SECTION

10
11
14
15

Oregon State Water Filings

TOWNSHIP 39s, RANGE 13E, W. M.

North

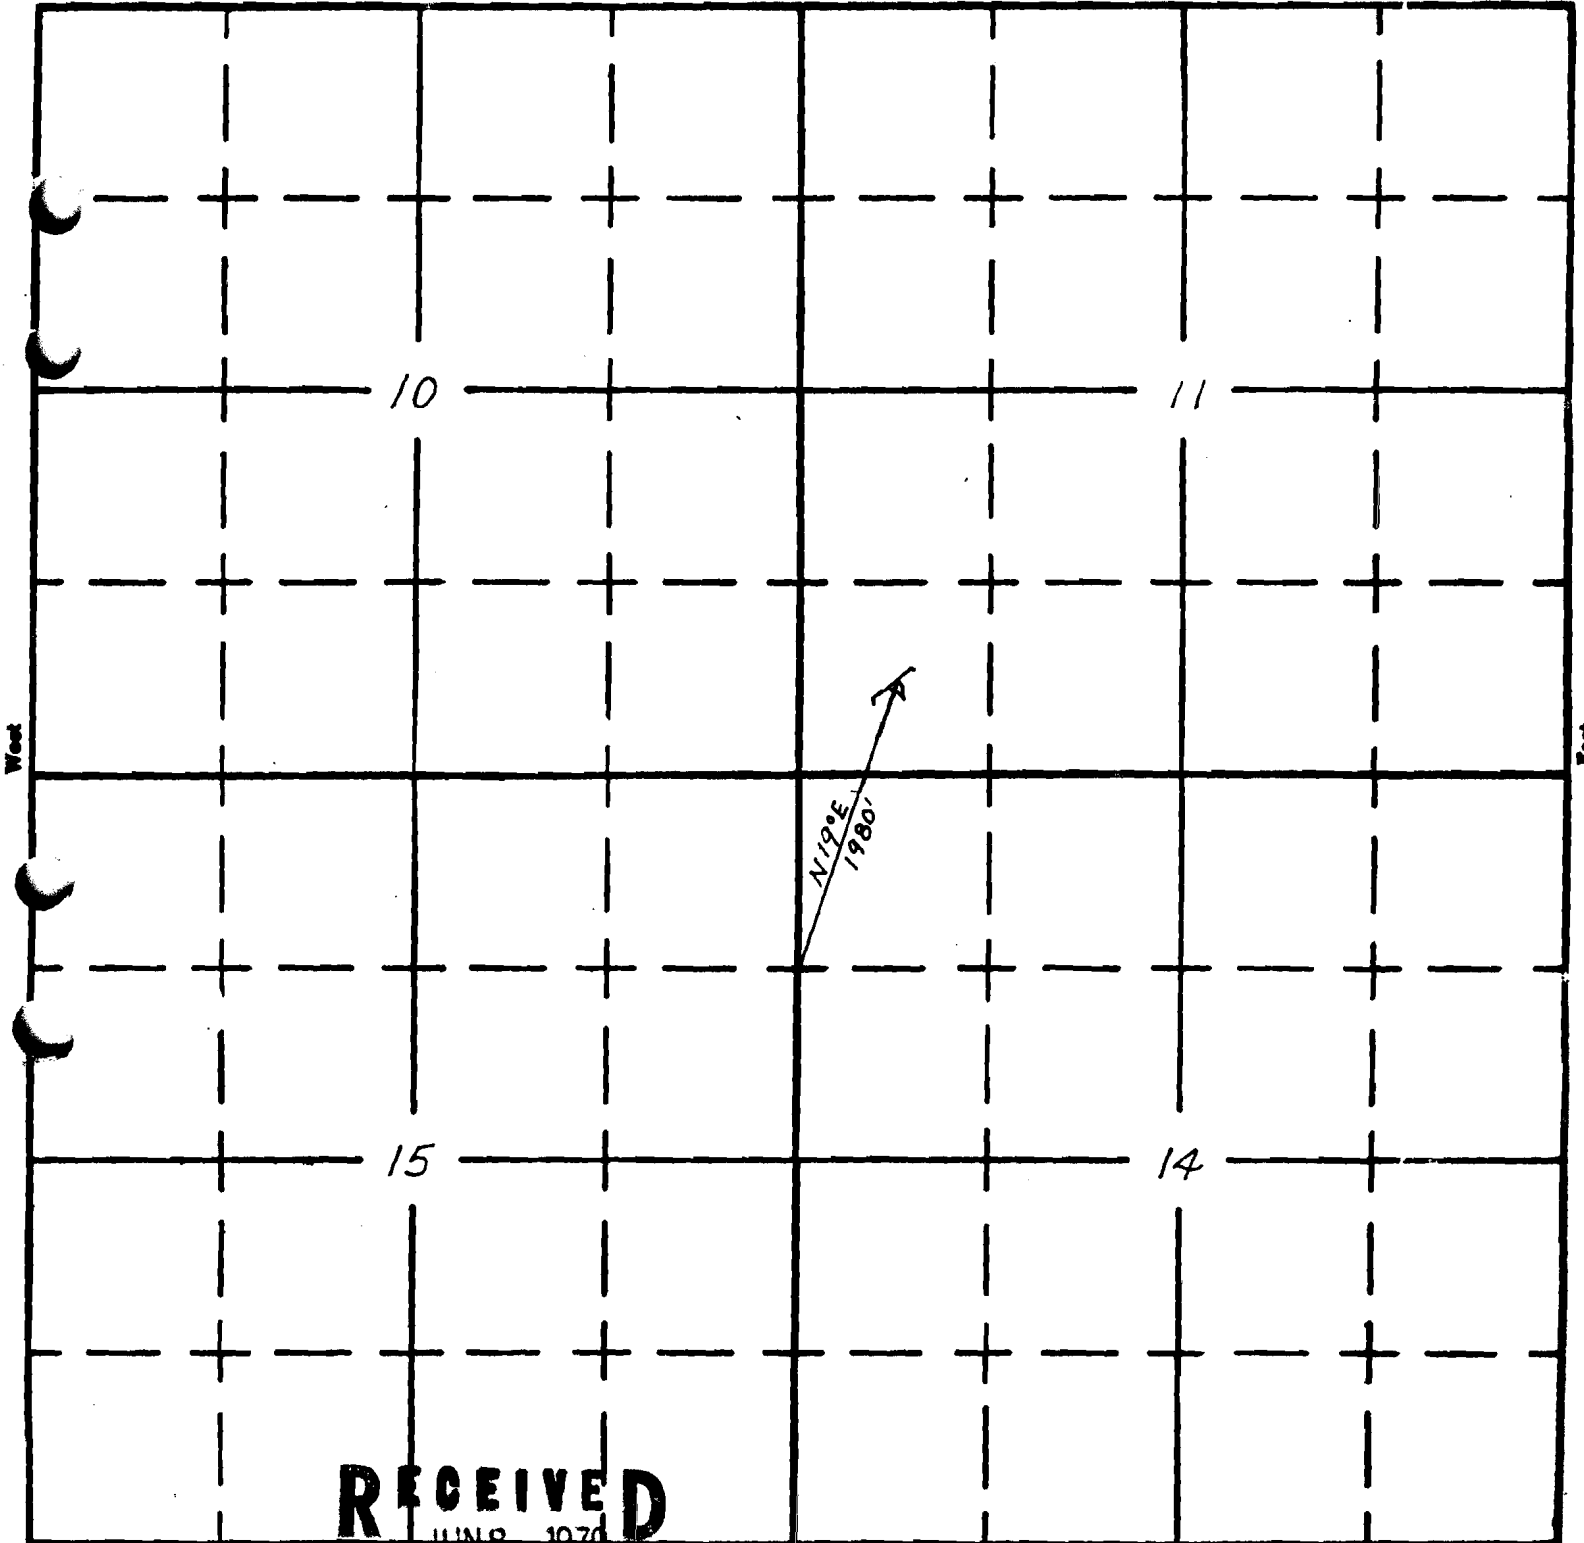

RECEIVED

JUN 8 1970

STATE ENGINEER
SALEM, OREGON

South

APPLICATION NO. P 47053
R 7398