

UNITED STATES
DEPARTMENT OF THE INTERIOR
BUREAU OF LAND MANAGEMENT


SECTION

SW¹/₄ NW¹/₄ 30

Oregon State Water Filings

TOWNSHIP 38-S, RANGE 26-E, W. M.

*No corner found - tied in with
aerial photo and OSMD quad sheet*

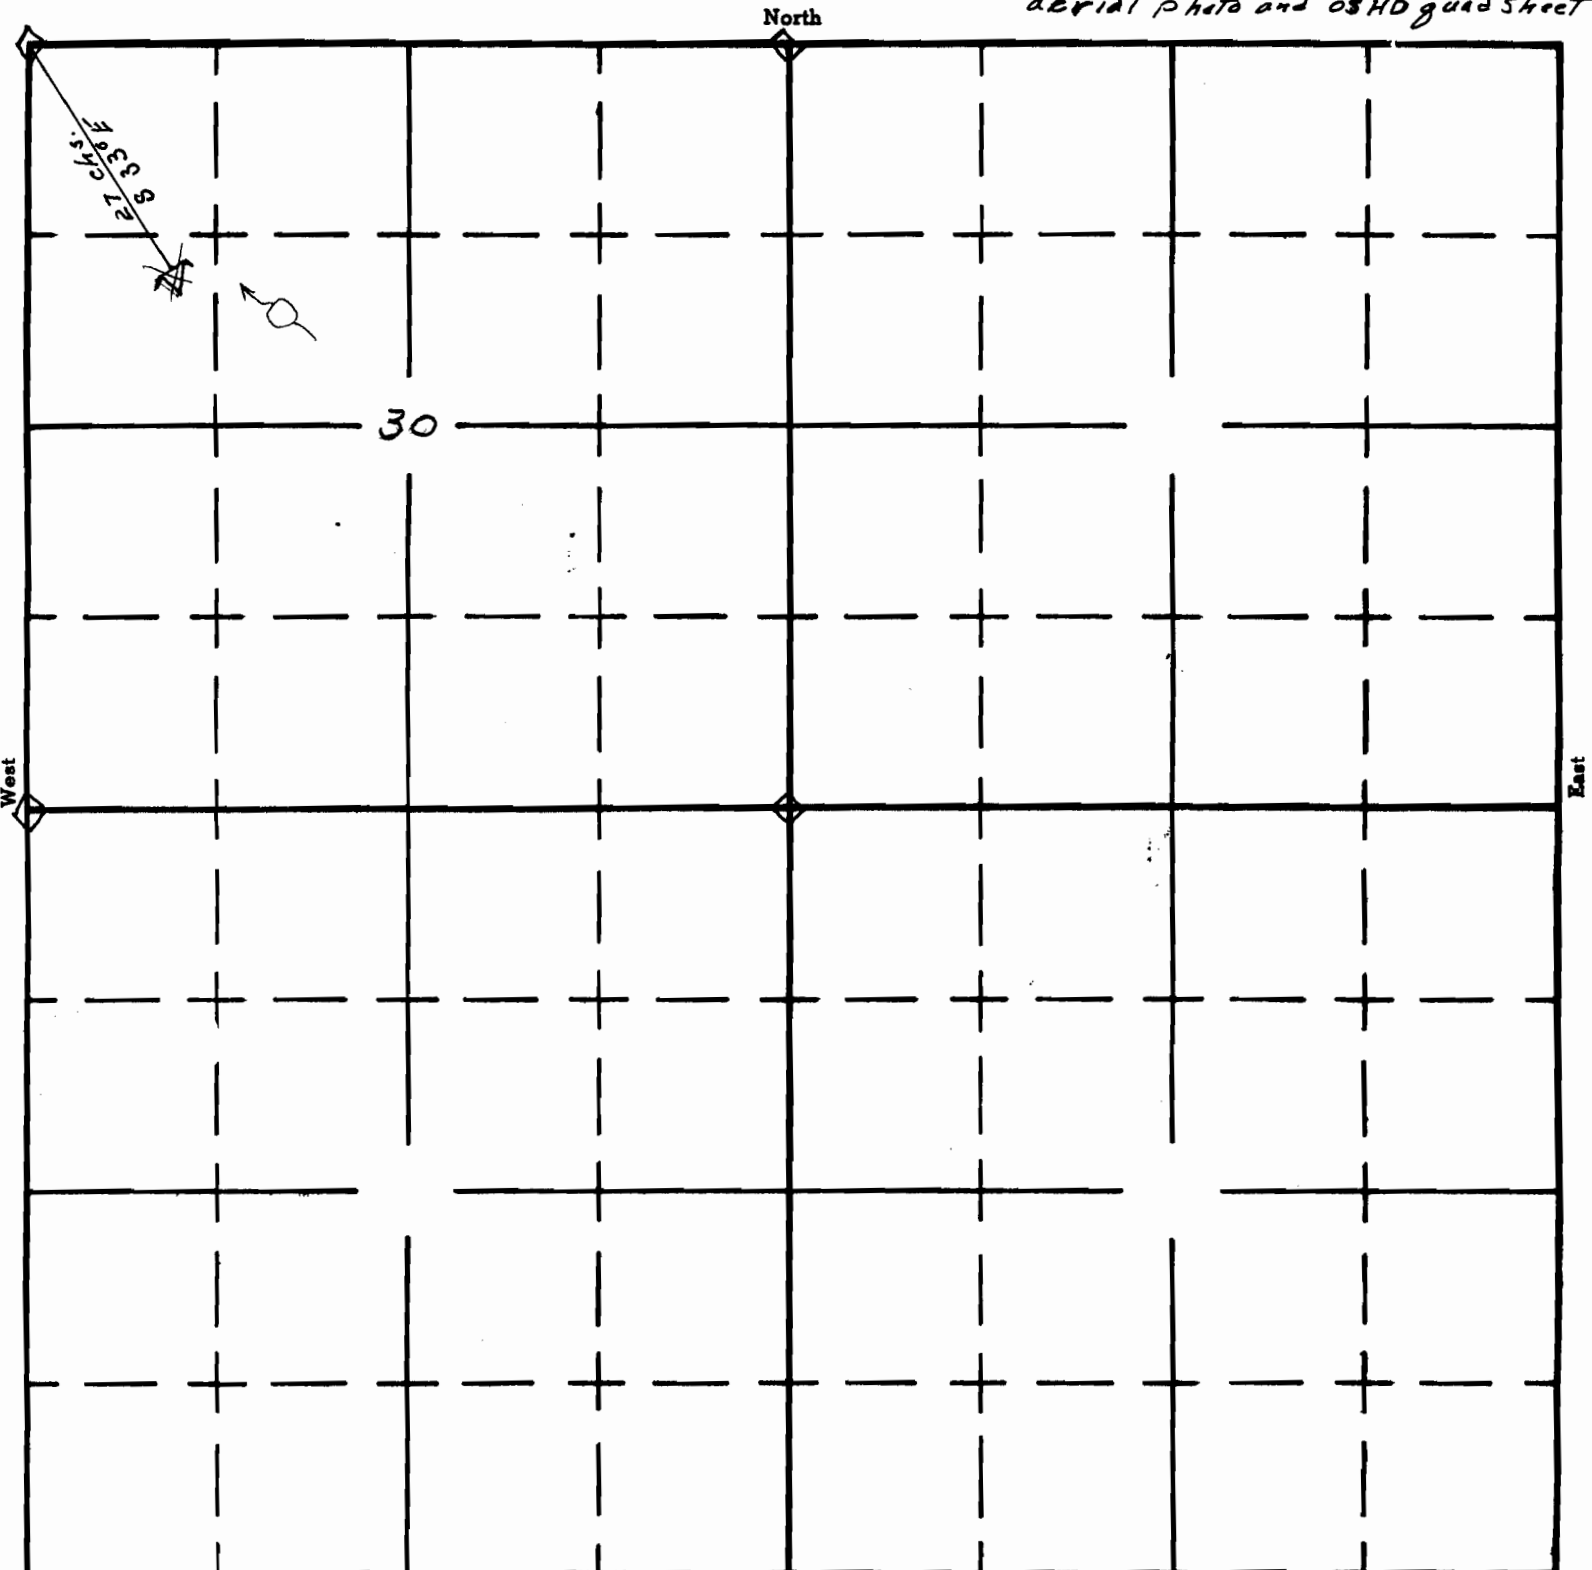

Mud Lake Reservoir 7 1/2' quod

APPLICATION No. R-34698
PERMIT No. R-2798