


UNITED STATES
DEPARTMENT OF THE INTERIOR
BUREAU OF LAND MANAGEMENT

RECEIVED
JUN 23 1961
STATE ENGINEER
SALEM, OREGON

SECTION 14

Oregon State Water Filings

TOWNSHIP 30-S, RANGE 27-E, W. M.

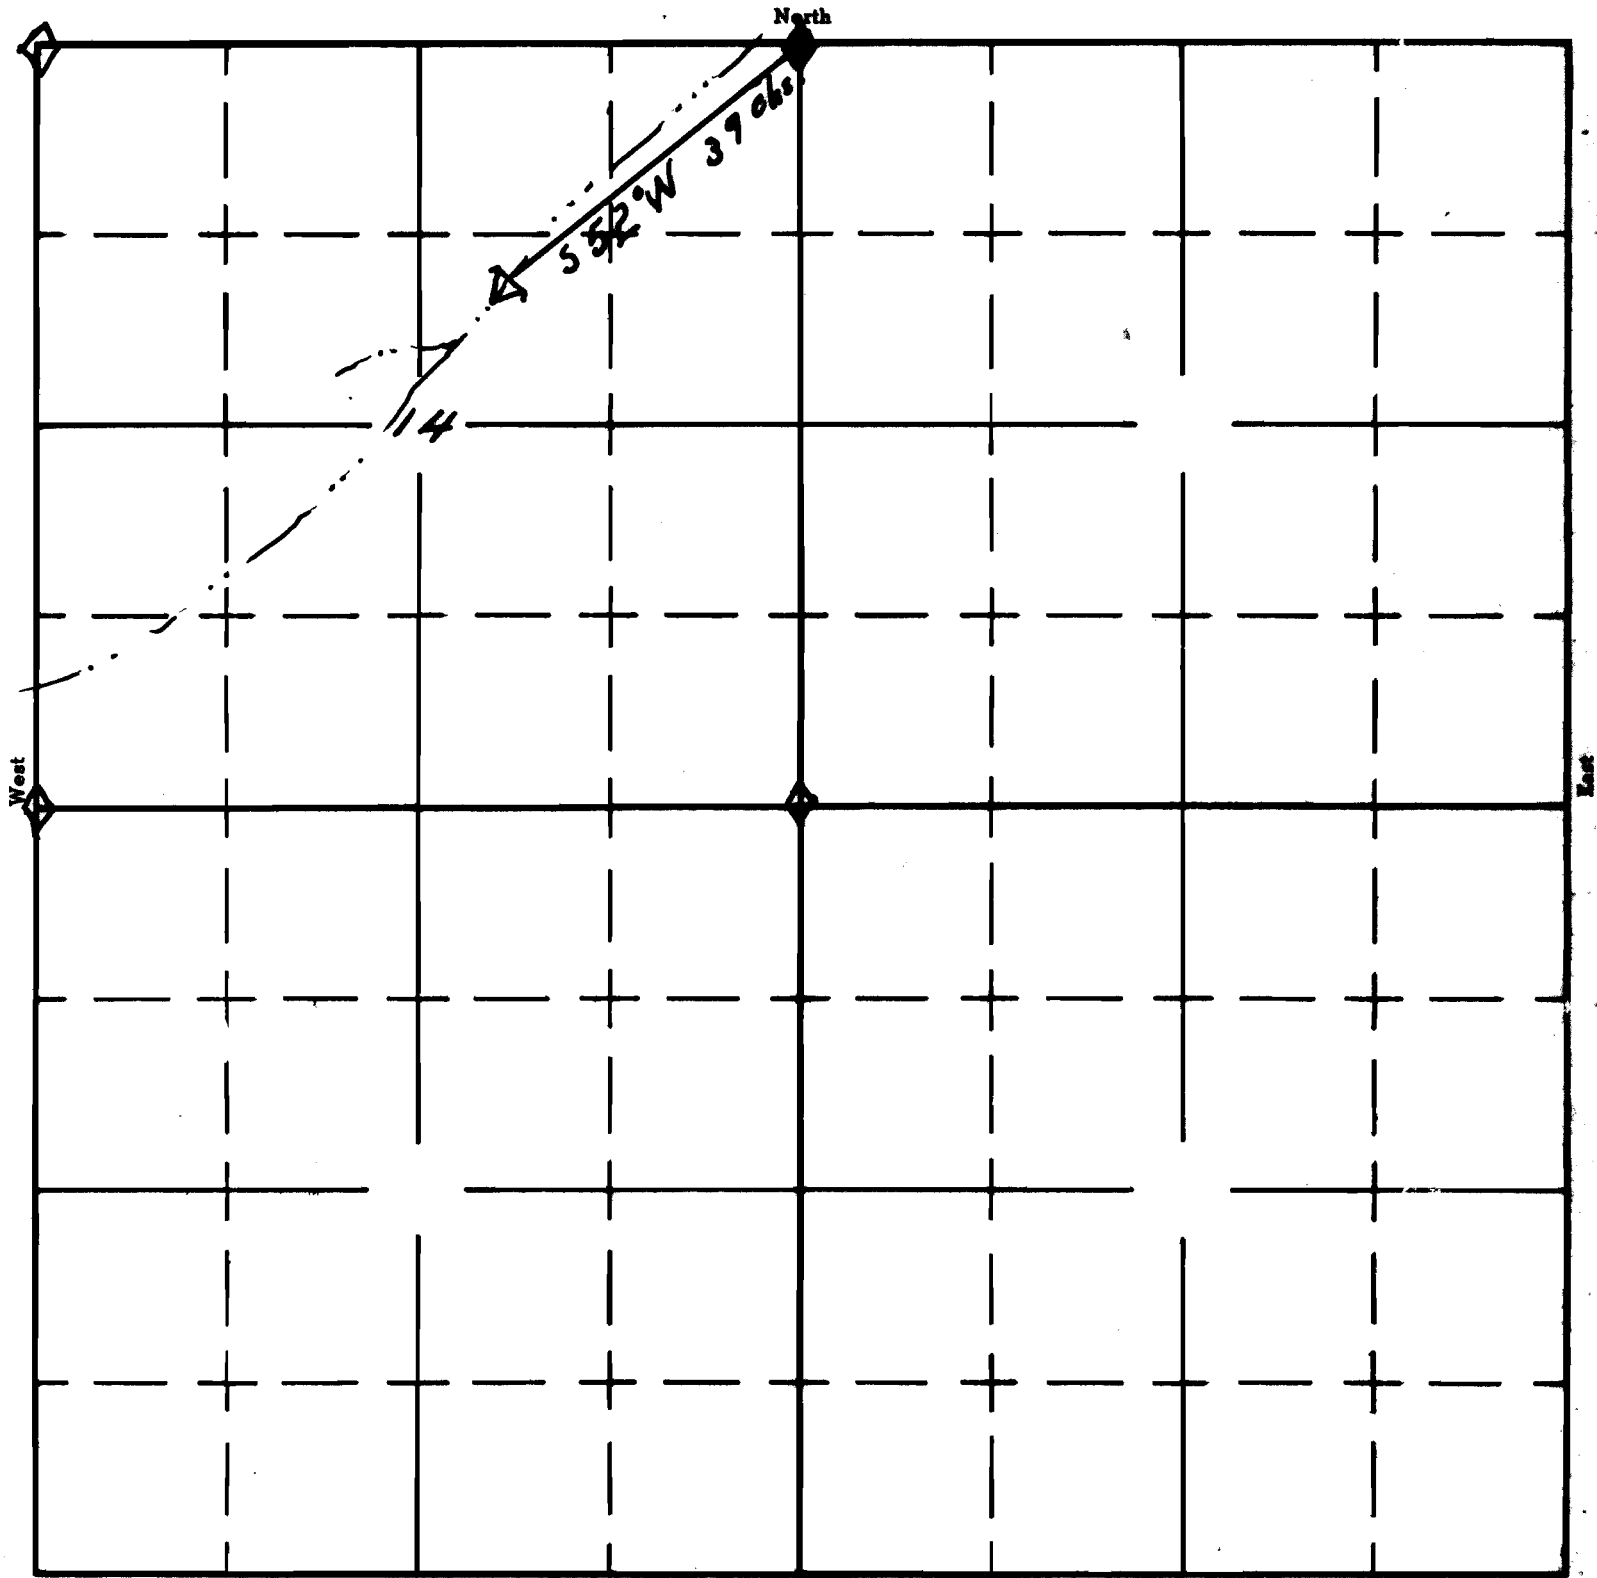

Balls Lake 7 1/2' quad

South

APPLICATION No. R-35071
PERMIT No. R-2812