


UNITED STATES
DEPARTMENT OF THE INTERIOR
BUREAU OF LAND MANAGEMENT

SECTION 15
NW 1/4 NW 1/4

Oregon State Water Filings
TOWNSHIP 30 S, RANGE 23 E, W. M.

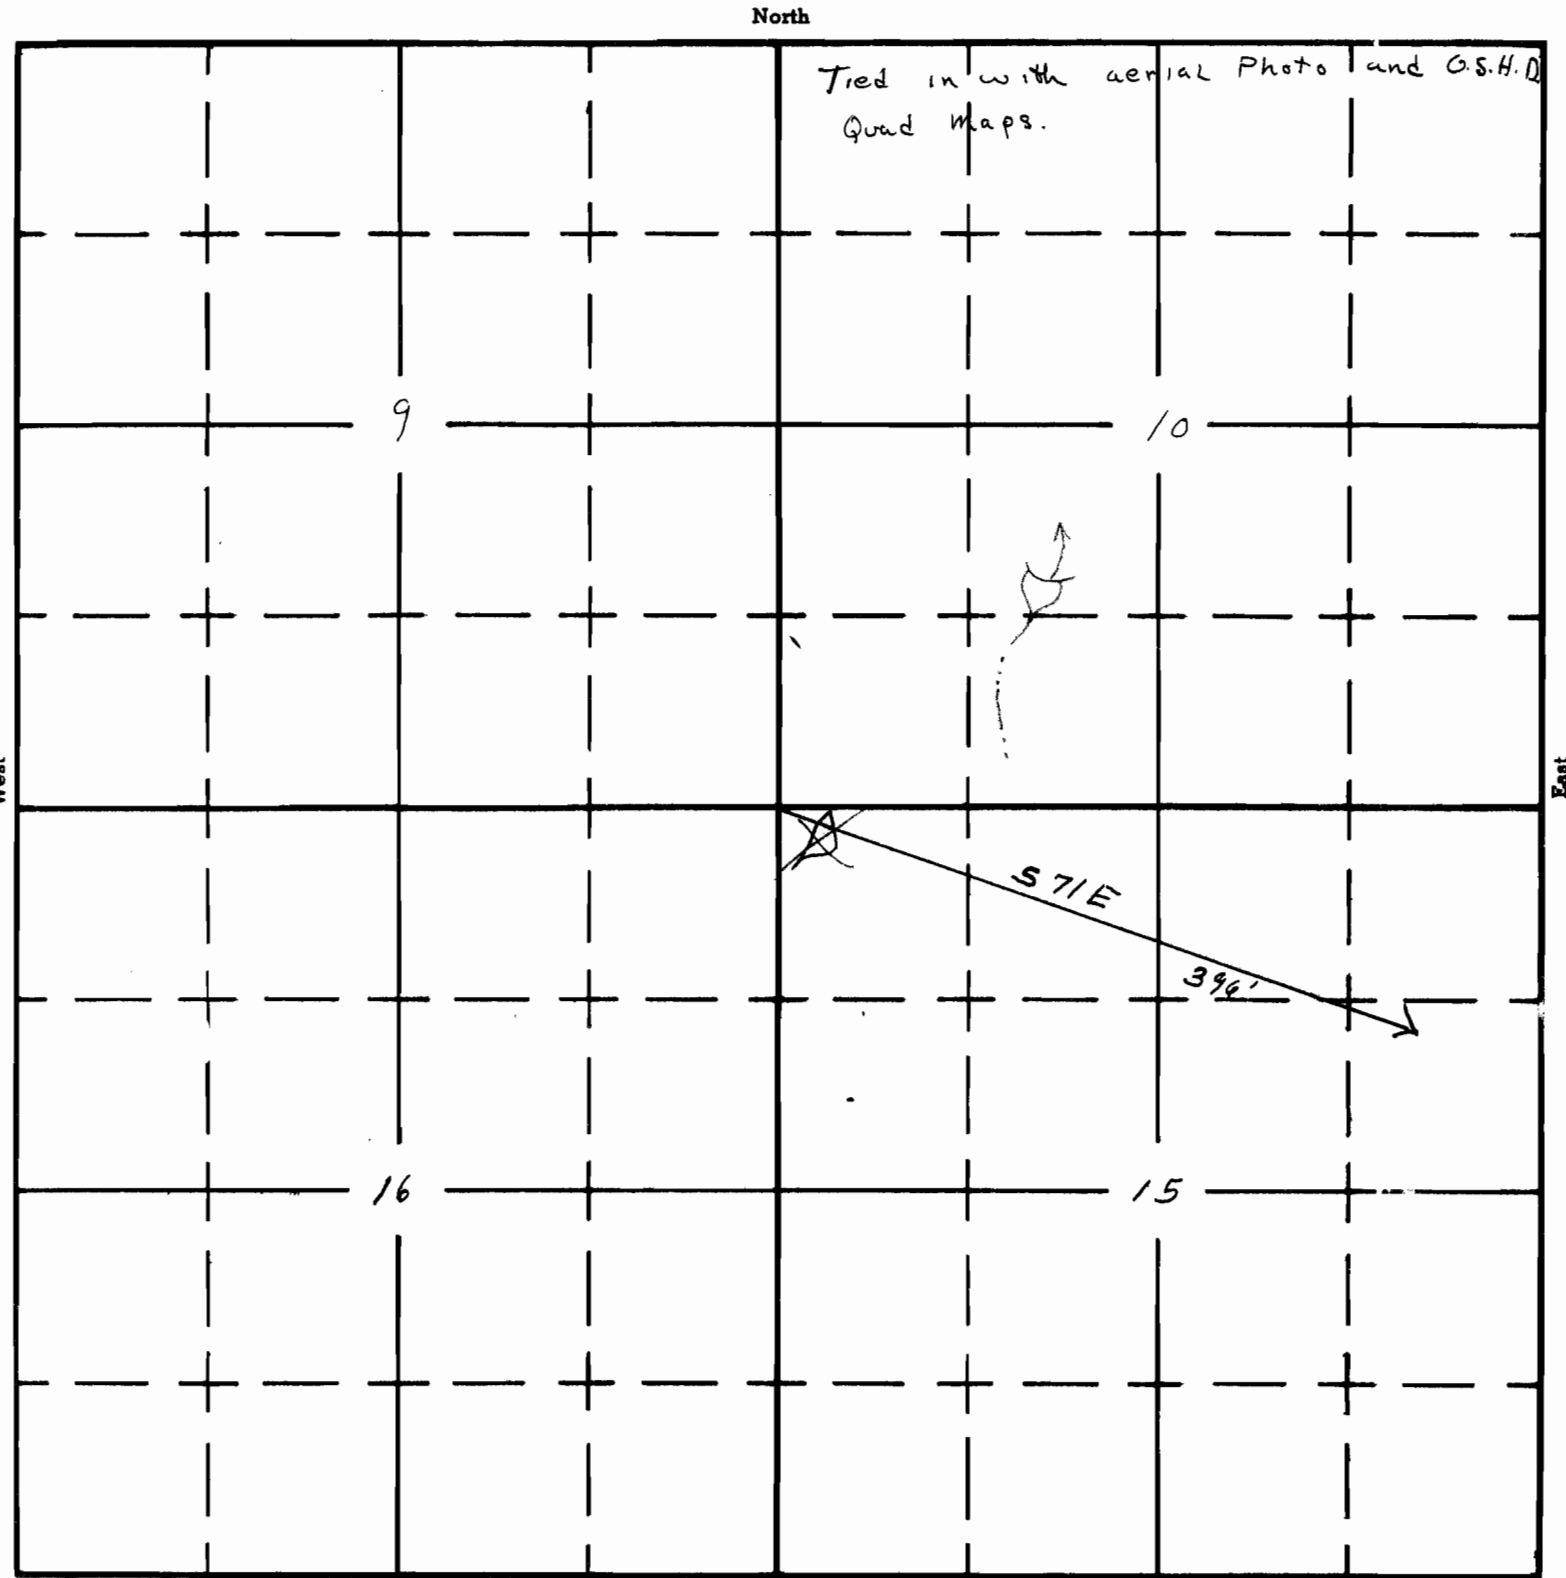

May Lake 7 1/2' quad