

Form A1-187
March 1961


UNITED STATES
DEPARTMENT OF THE INTERIOR
BUREAU OF LAND MANAGEMENT

SECTION
NE ~~SW~~ NW Sec. 1

Oregon State Water Filings

TOWNSHIP 39S, RANGE 26E, W. M.

RECEIVED
SEP 8 1961
STATE ENGINEER
ASH, OREGON

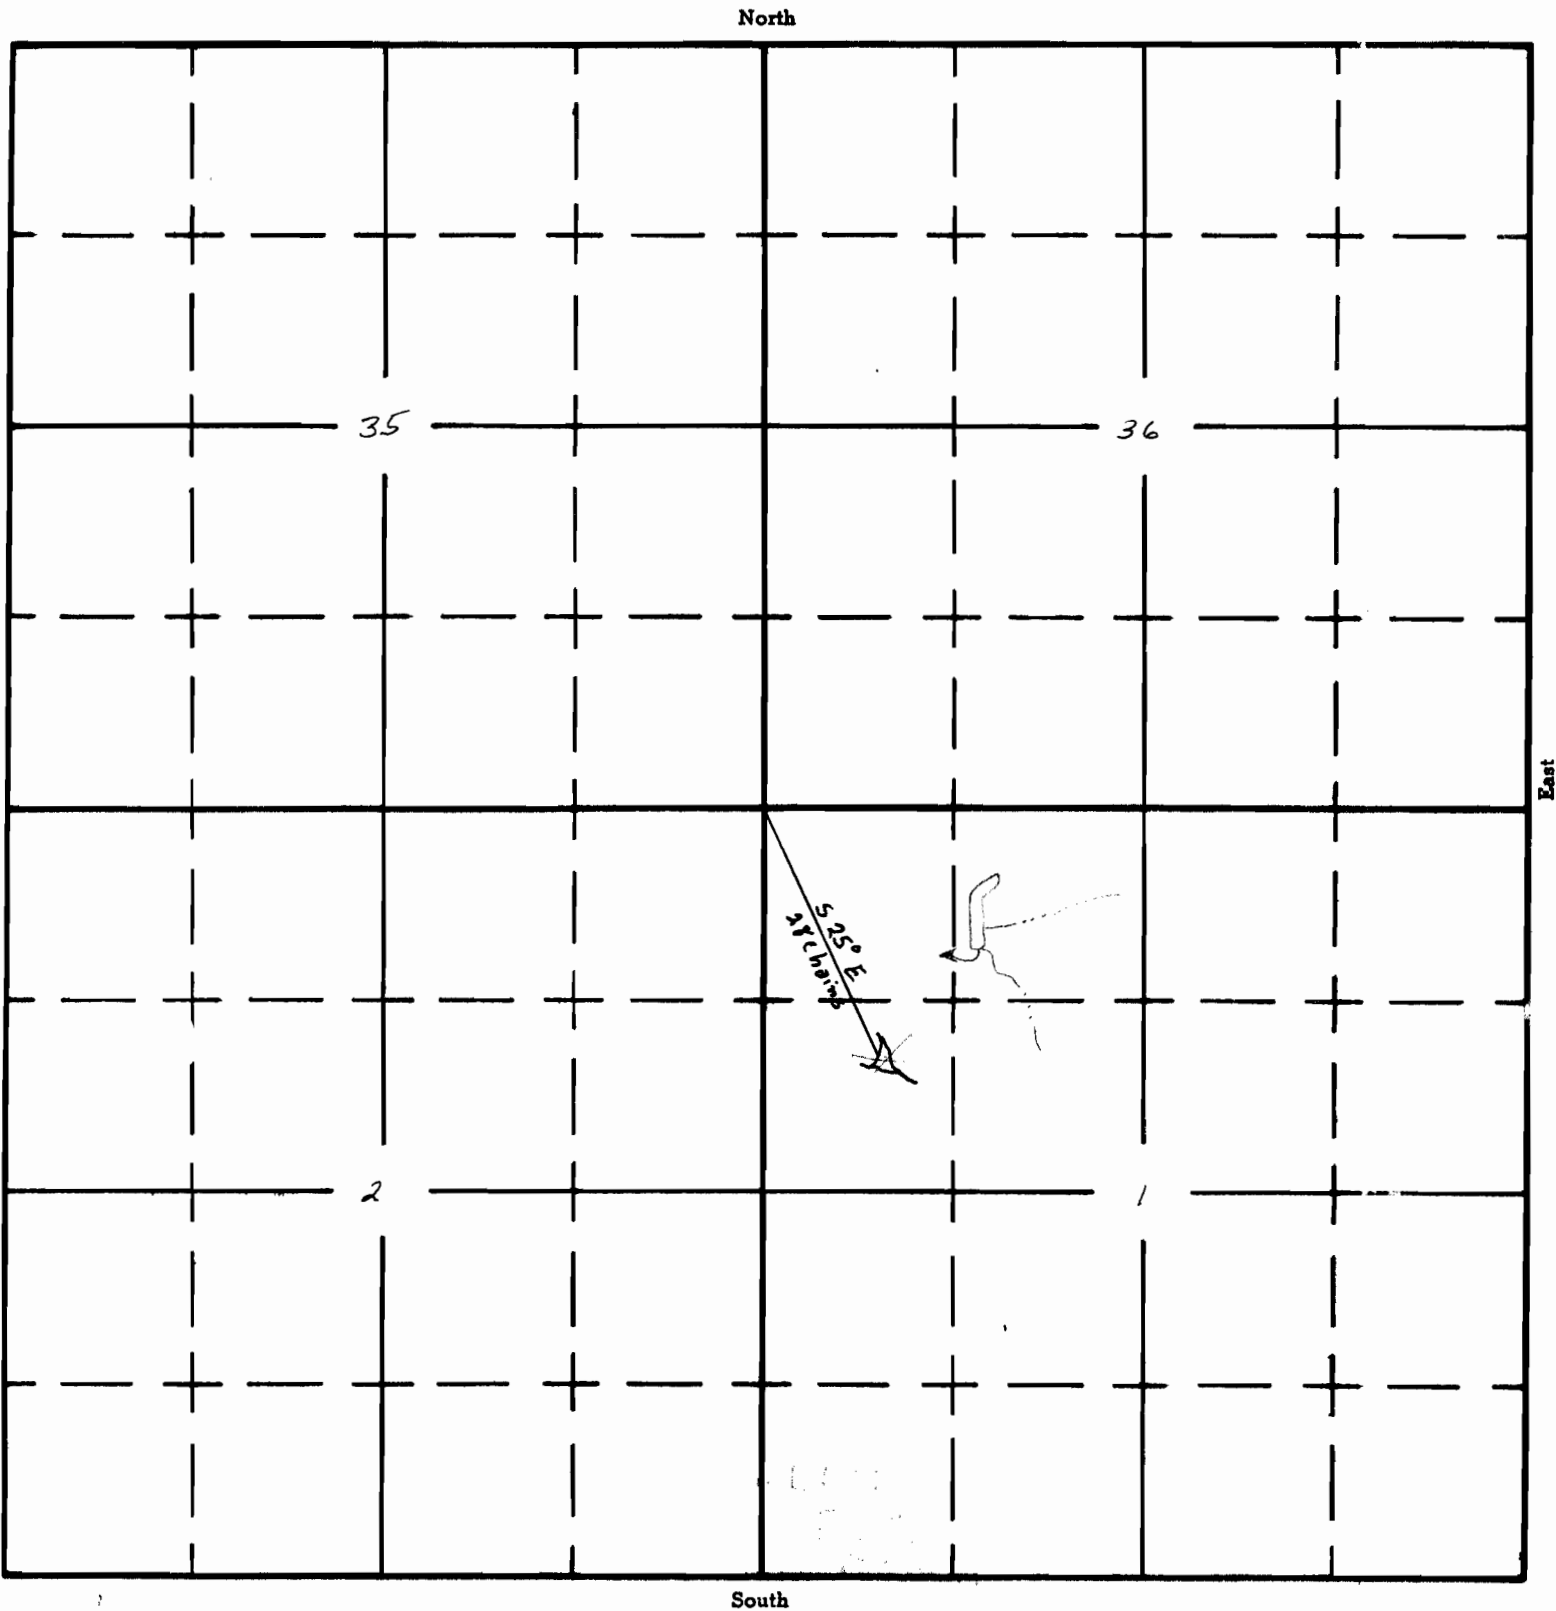

Mud Lake Reservoir 7 1/2' quad

APPLICATION No. R-35175
PERMIT No. R-2968