

UNITED STATES
DEPARTMENT OF THE INTERIOR
BUREAU OF LAND MANAGEMENT

SECTION


20

Oregon State Water Filings

NE 1/4 NE 1/4

TOWNSHIP 41S, RANGE 26E, W. M.

North

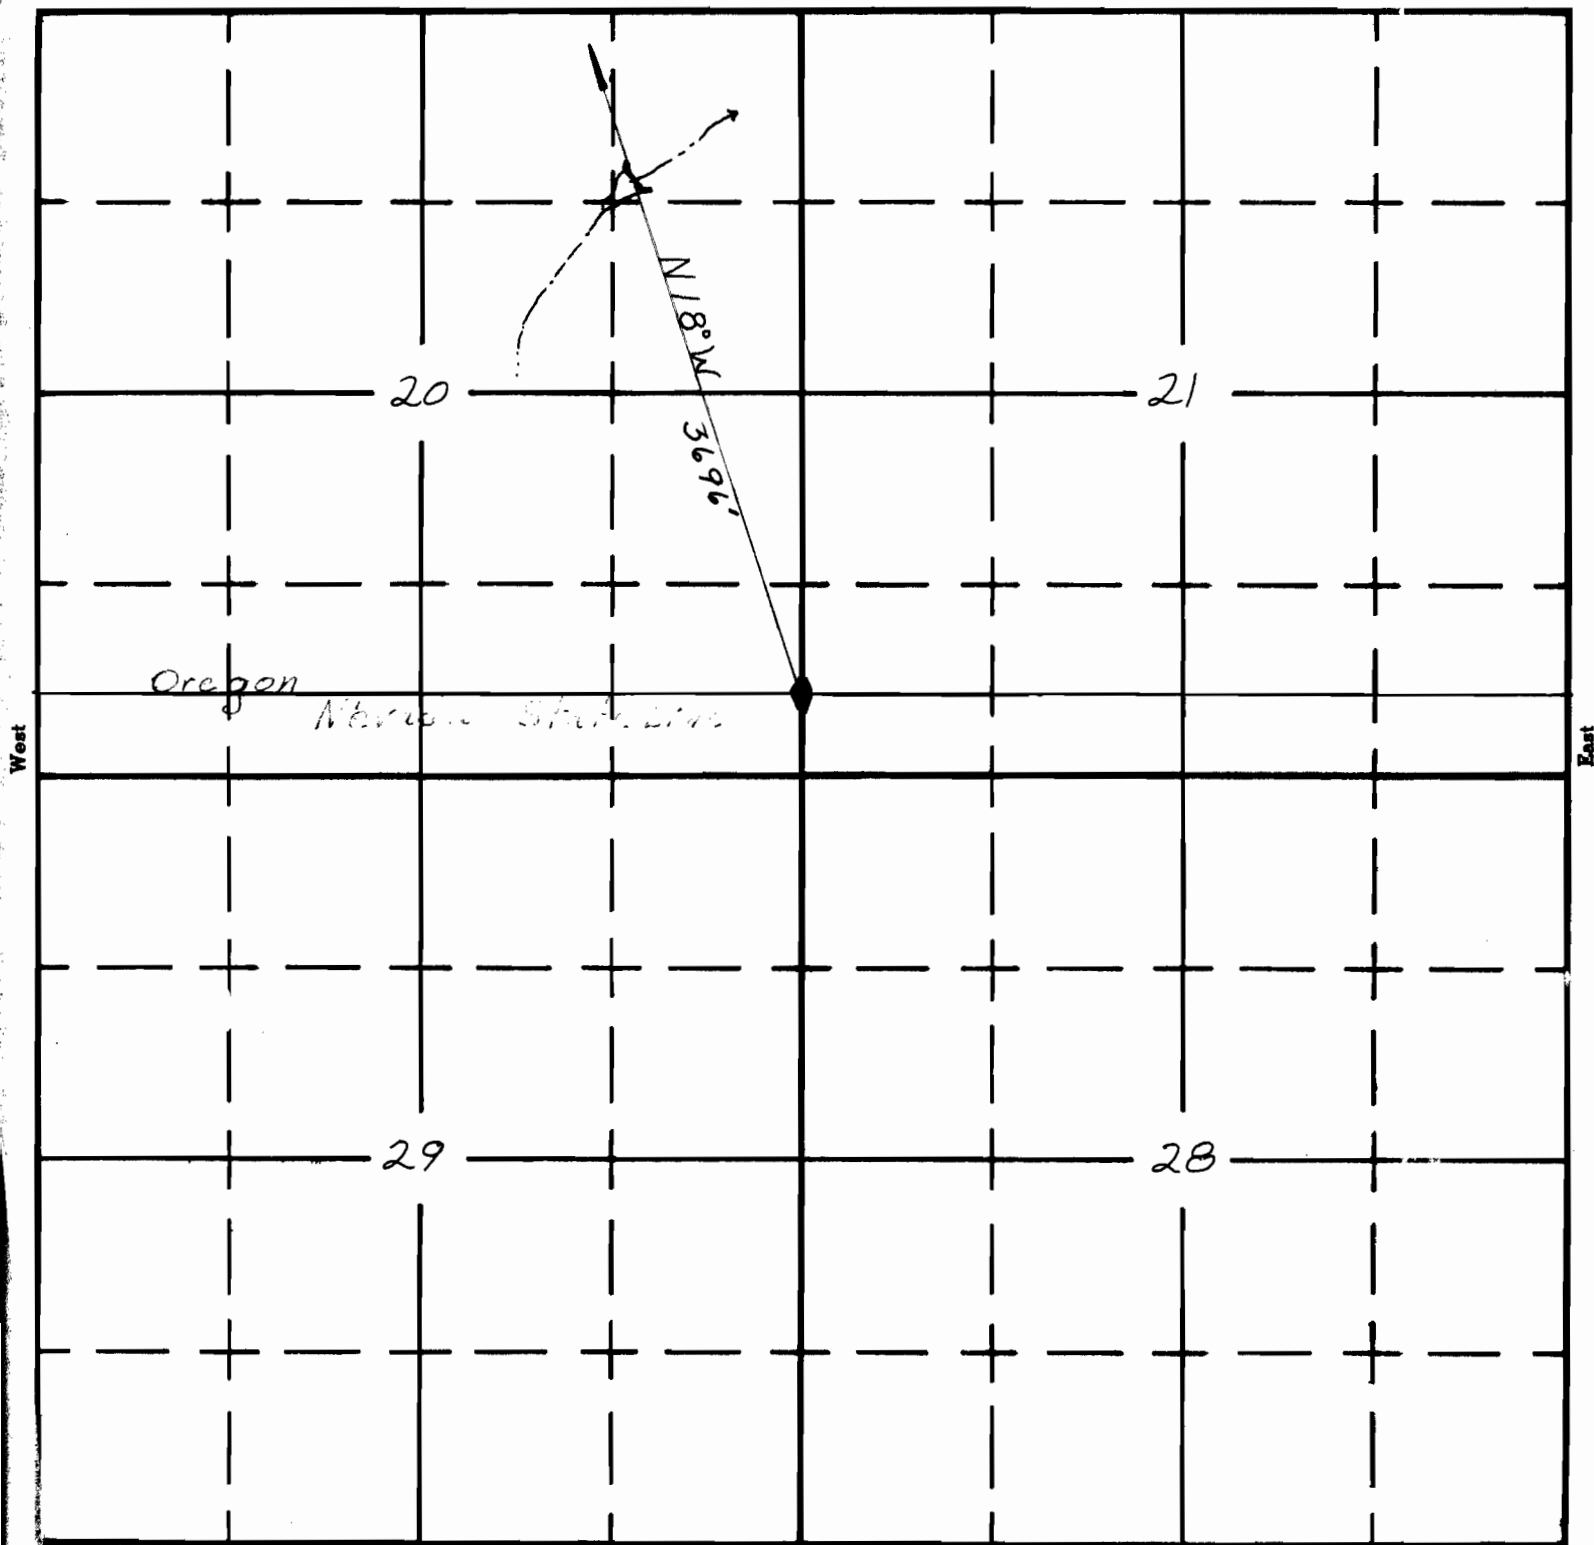

Tin-can Res.
01-R-253

Blizzard Gap 7 1/2' quad

APPLICATION No. R-38597
PERMIT No. R-3262