

R3338

51078

51402

Form AI-187
March 1961

UNITED STATES
DEPARTMENT OF THE INTERIOR
BUREAU OF LAND MANAGEMENT

RECEIVED
APR 5 1968
C. E. ENGINEER
PORTLAND, OREGON

SECTION 2


Oregon State Water Filings

NW 1/4 NE 1/4

TOWNSHIP 41S, RANGE 24E, W. M.

R 3338

North

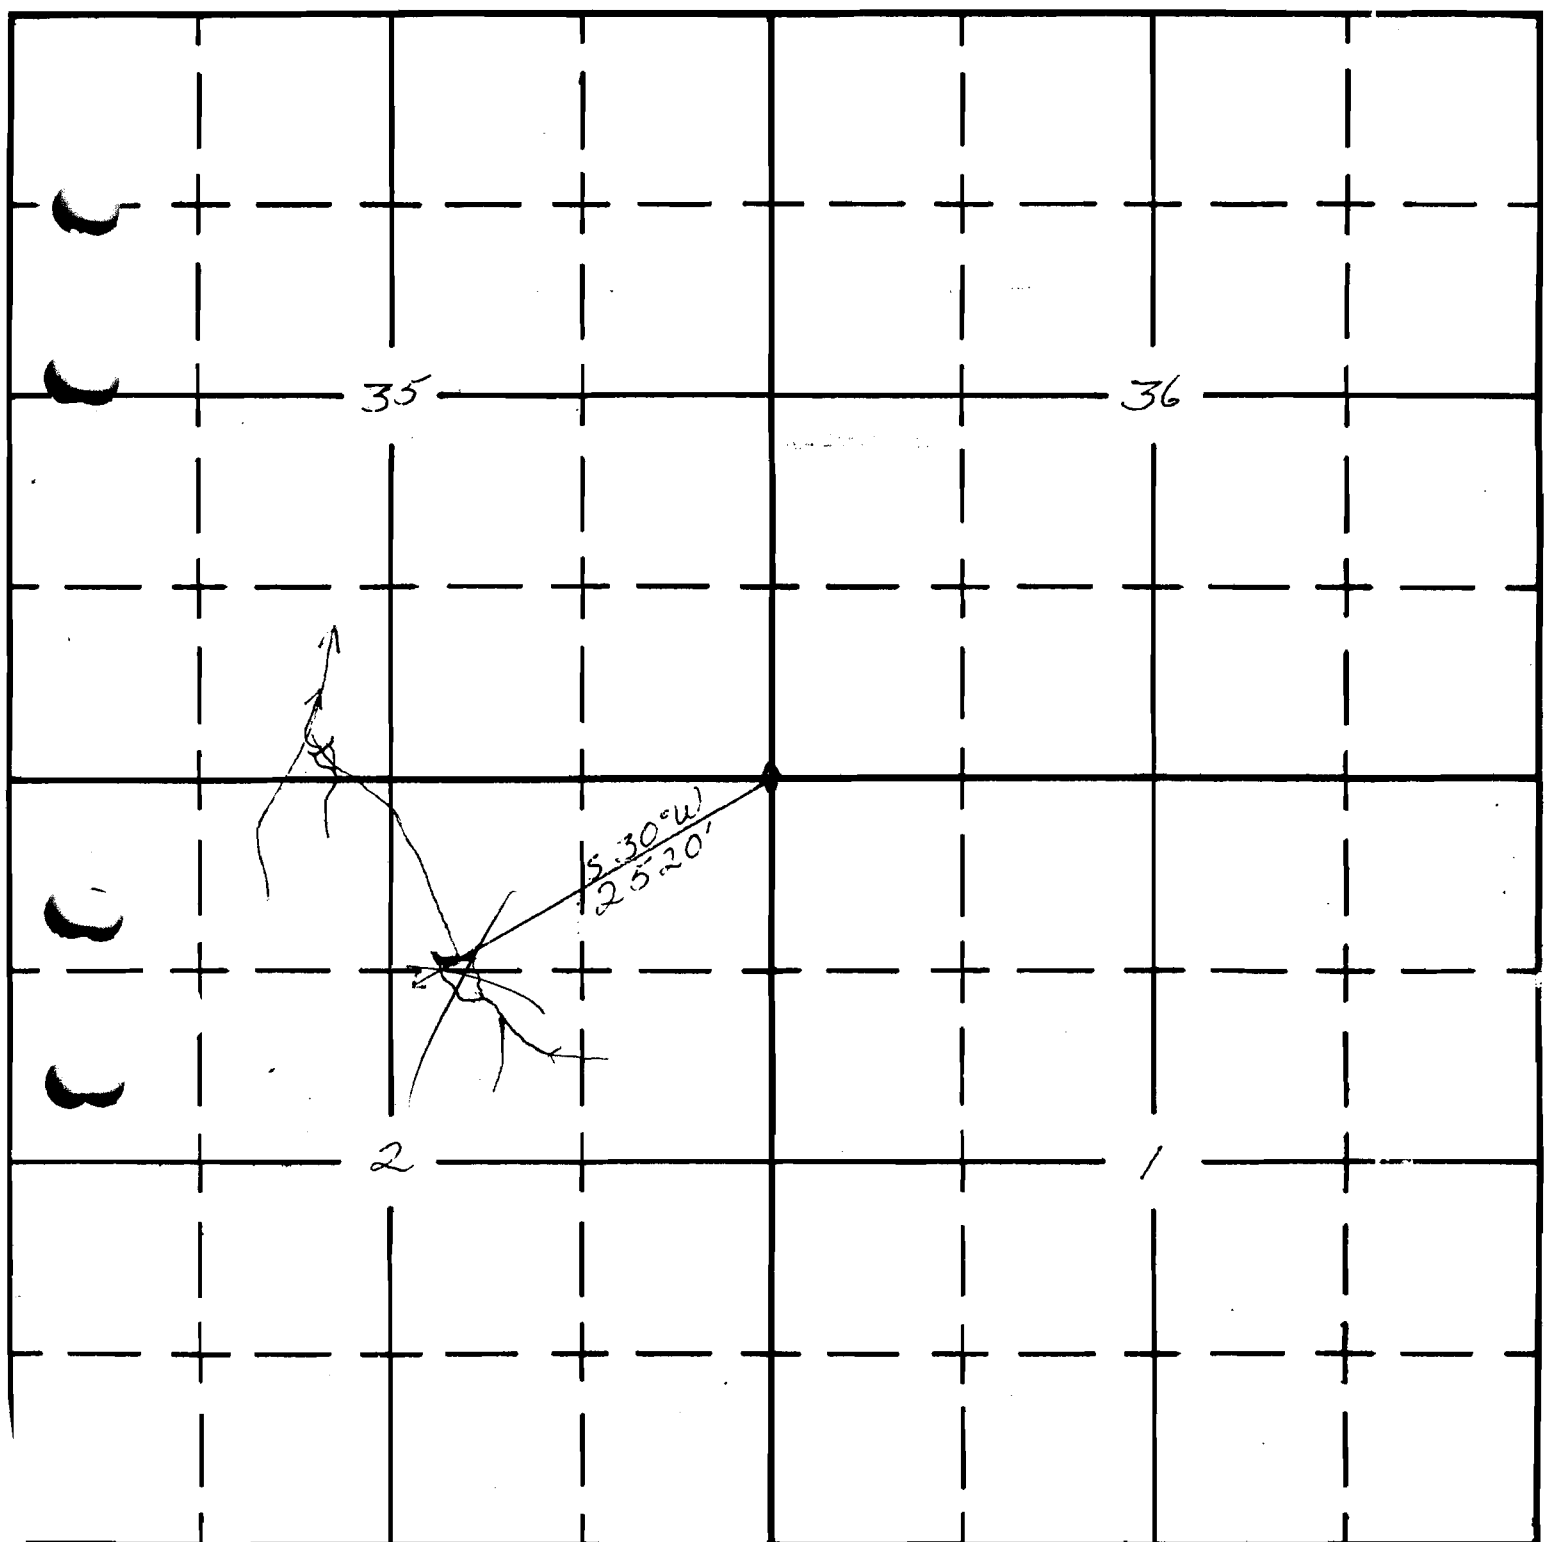

South

Tucker Flat #1 Res. #25
7 1/2' quad Coleman Lake

APPLICATION No. R-38603
PERMIT No. R-3338