

Form A1-187
March 1961

UNITED STATES
DEPARTMENT OF THE INTERIOR
BUREAU OF LAND MANAGEMENT

SECTION


15

NE 1/4 SE 1/4

Oregon State Water Filings

TOWNSHIP 35S, RANGE 23E, W. M.

North Tied in with series Photo and OSHP and Maps

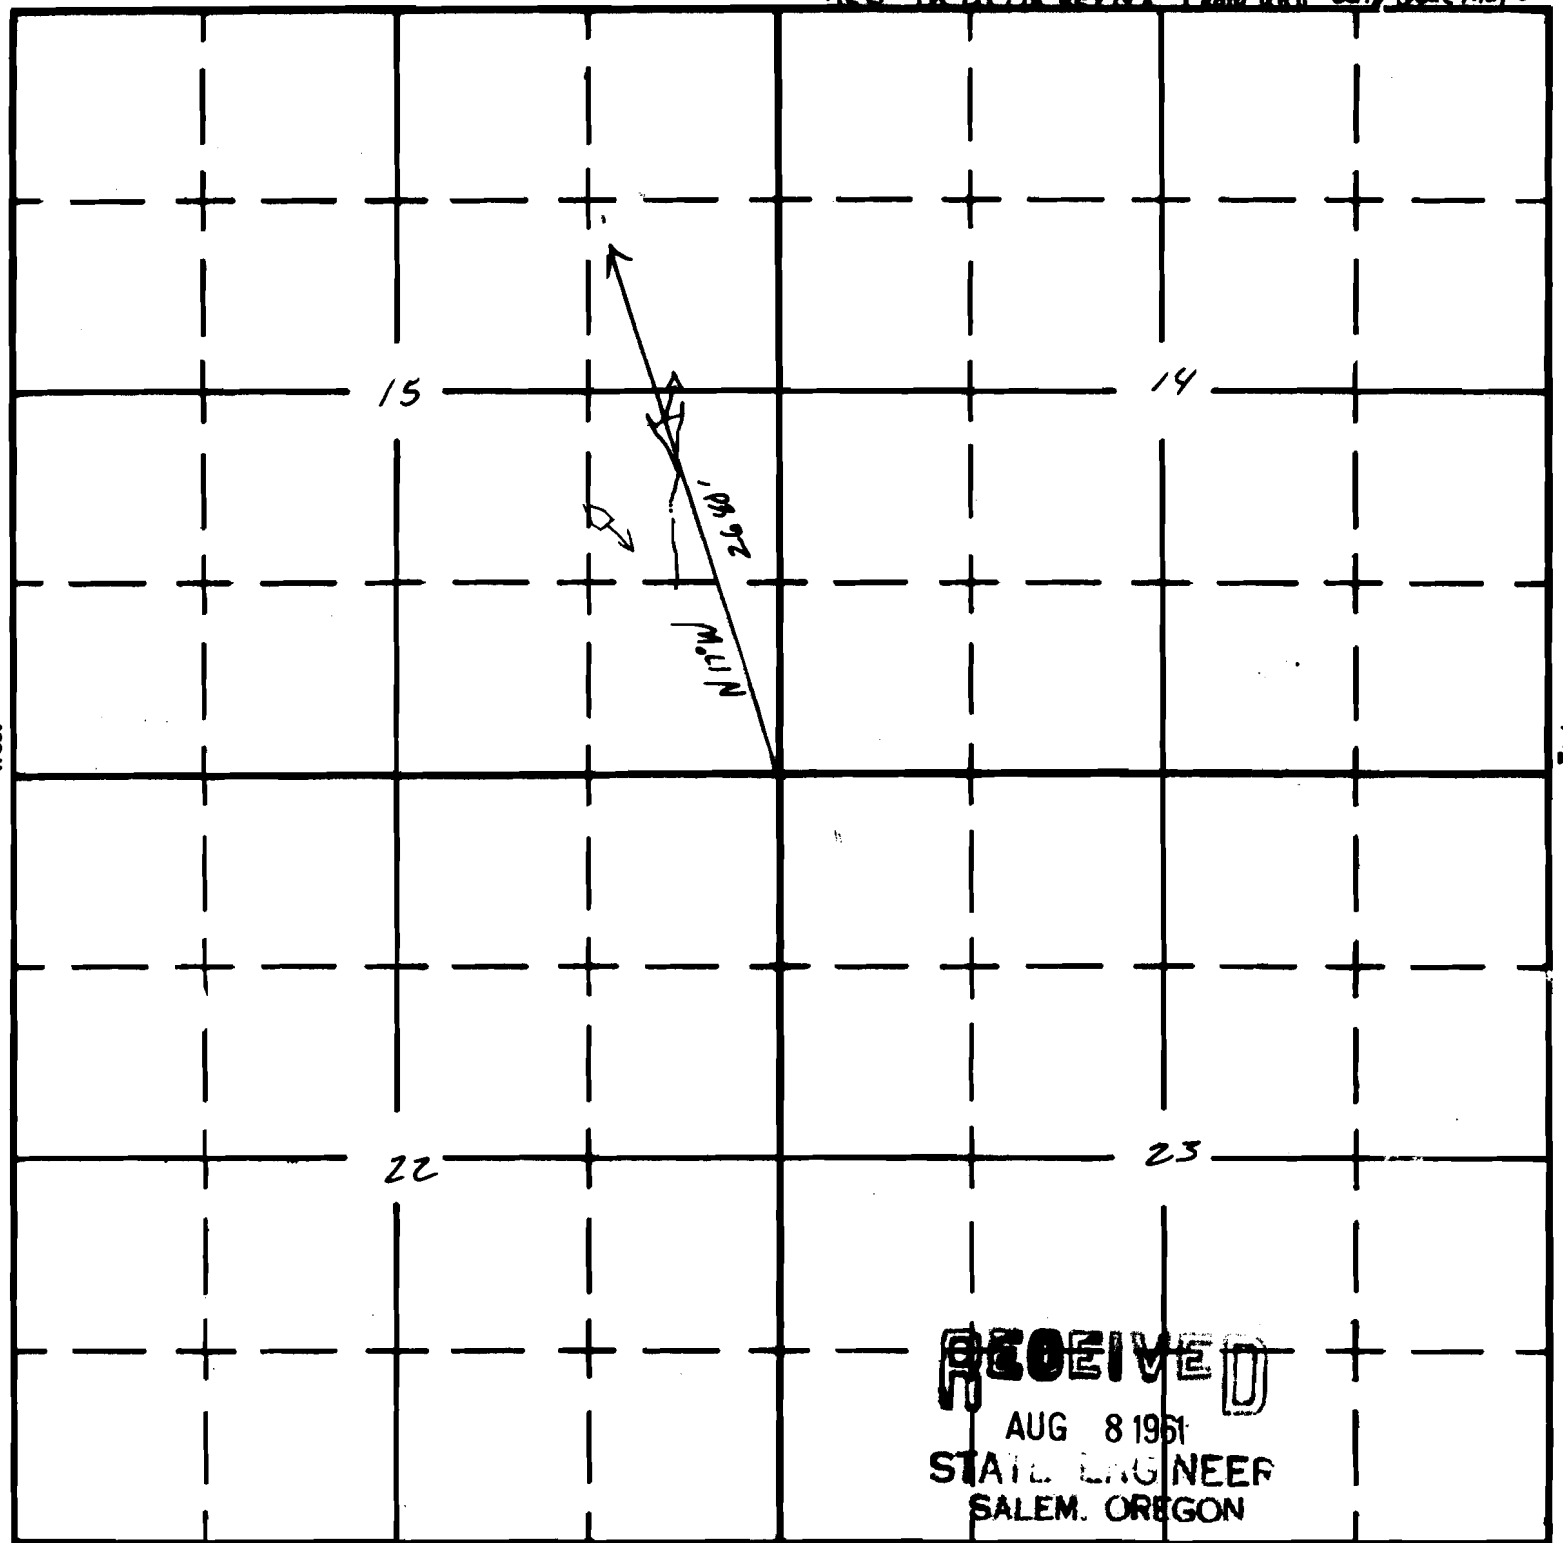

Rabbit Hills SW 7 1/2' quad

South

APPLICATION No. R-36461
PERMIT No. R-4102