


Form AI-187
March 1961

UNITED STATES
DEPARTMENT OF THE INTERIOR
BUREAU OF LAND MANAGEMENT

SECTION 3 Oregon State Water Filings

NW 1/4 NE 1/4 TOWNSHIP 41 S, RANGE 26 E, W. M.

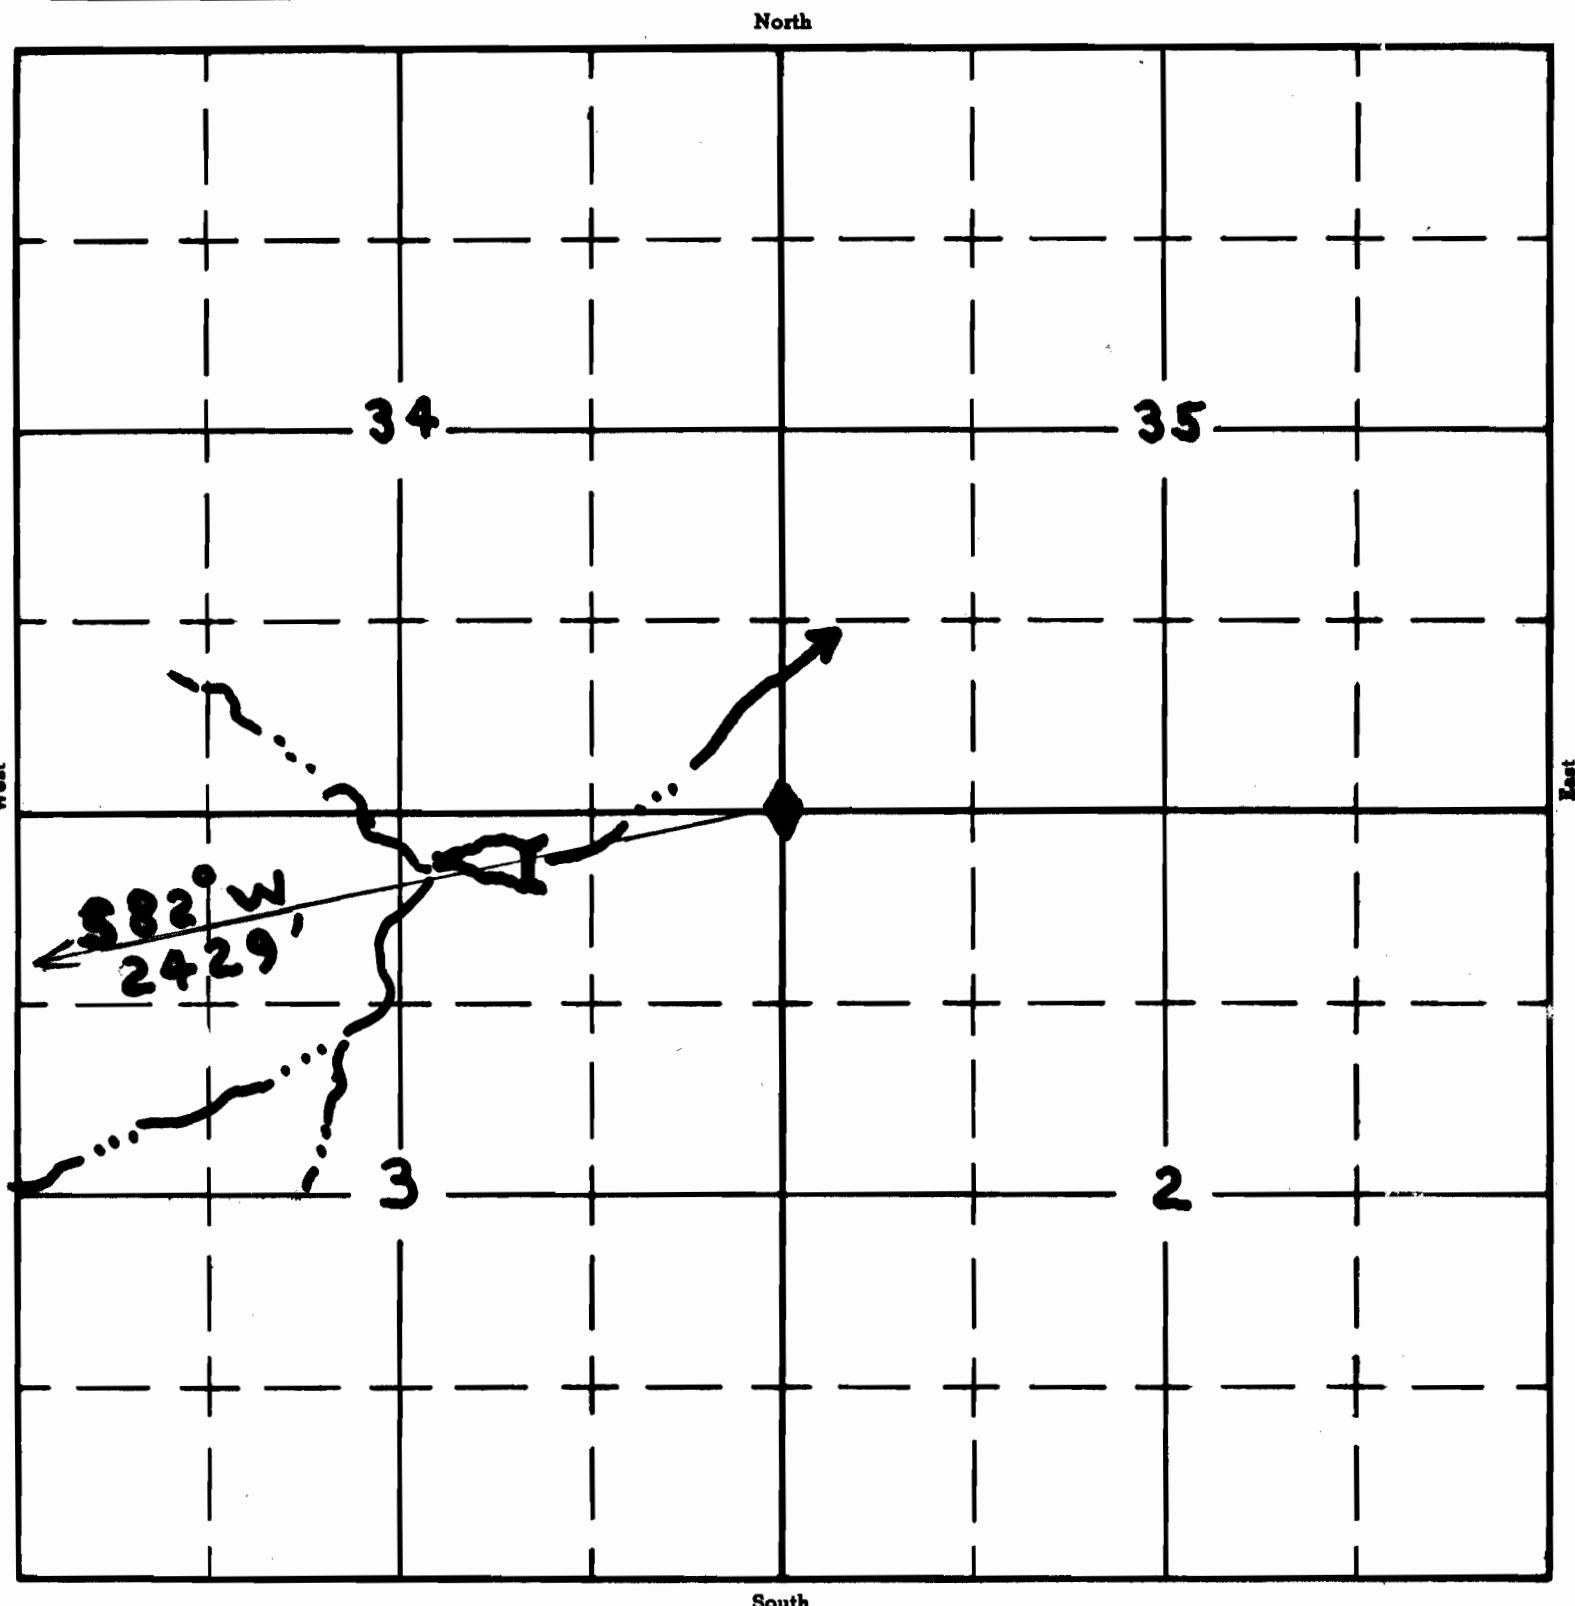

No Peek Res
01-R-288

Blizzard Gap 7 1/2' quad APPLICATION No. R-35203
PERMIT No. R-4158