


Form A1-187
March 1961

UNITED STATES
DEPARTMENT OF THE INTERIOR
BUREAU OF LAND MANAGEMENT

SECTION 10 3 Oregon State Water Filings

SW 1/4 NE 1/4 TOWNSHIP 41 S, RANGE 26 E, W. M.
SE 1/4 SE 1/4

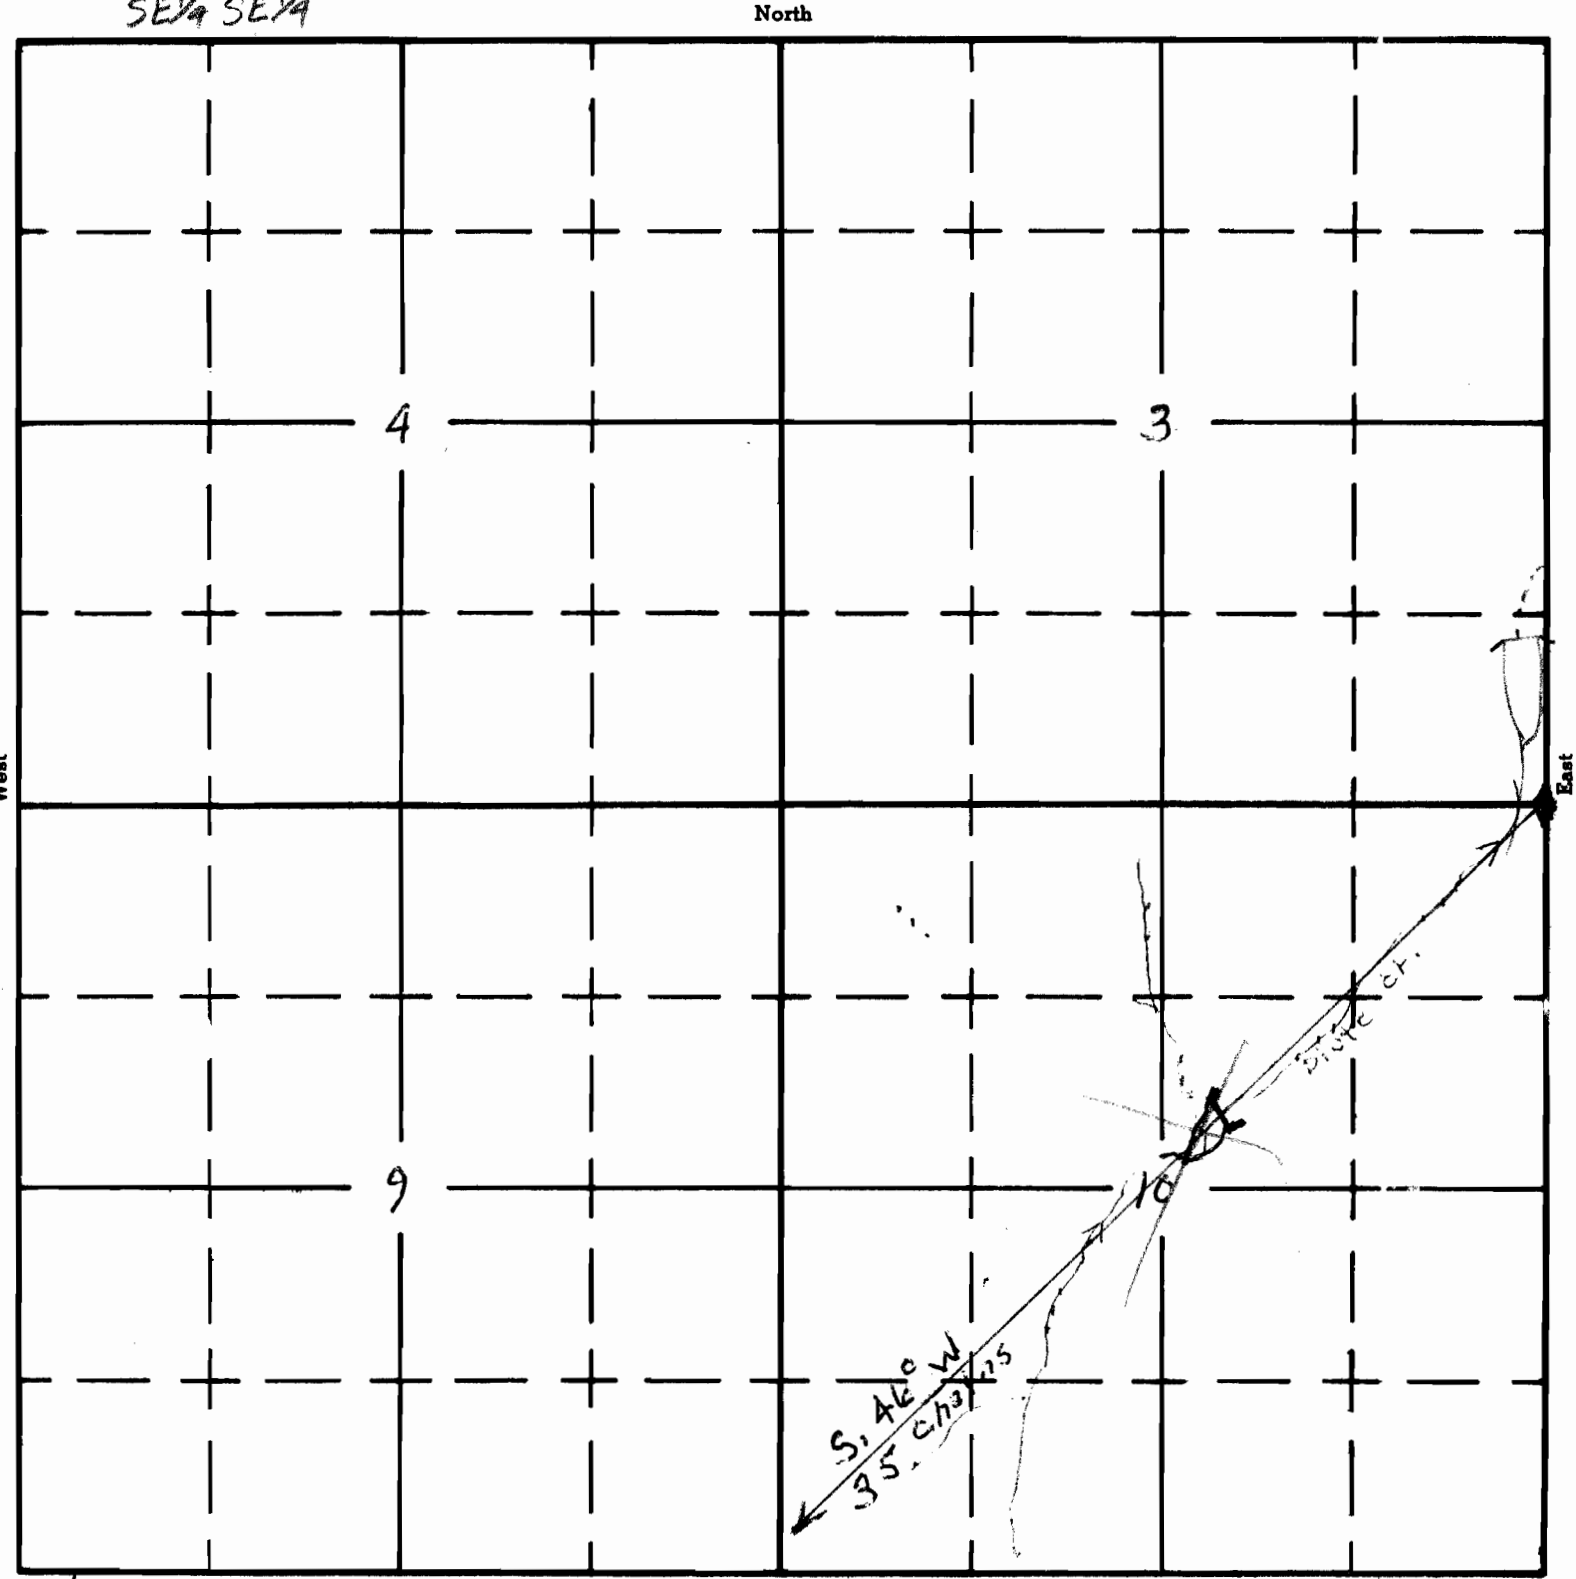

No. Dice Reservoir
01-R-287

R. 35204

APPLICATION No. R-35204
PERMIT No. R-4160