


Form AI-187
March 1961

UNITED STATES
DEPARTMENT OF THE INTERIOR
BUREAU OF LAND MANAGEMENT

SECTION 22 **Oregon State Water Filings**

NW 1/4 SW 1/4 TOWNSHIP 40s, RANGE 26E, W. M.

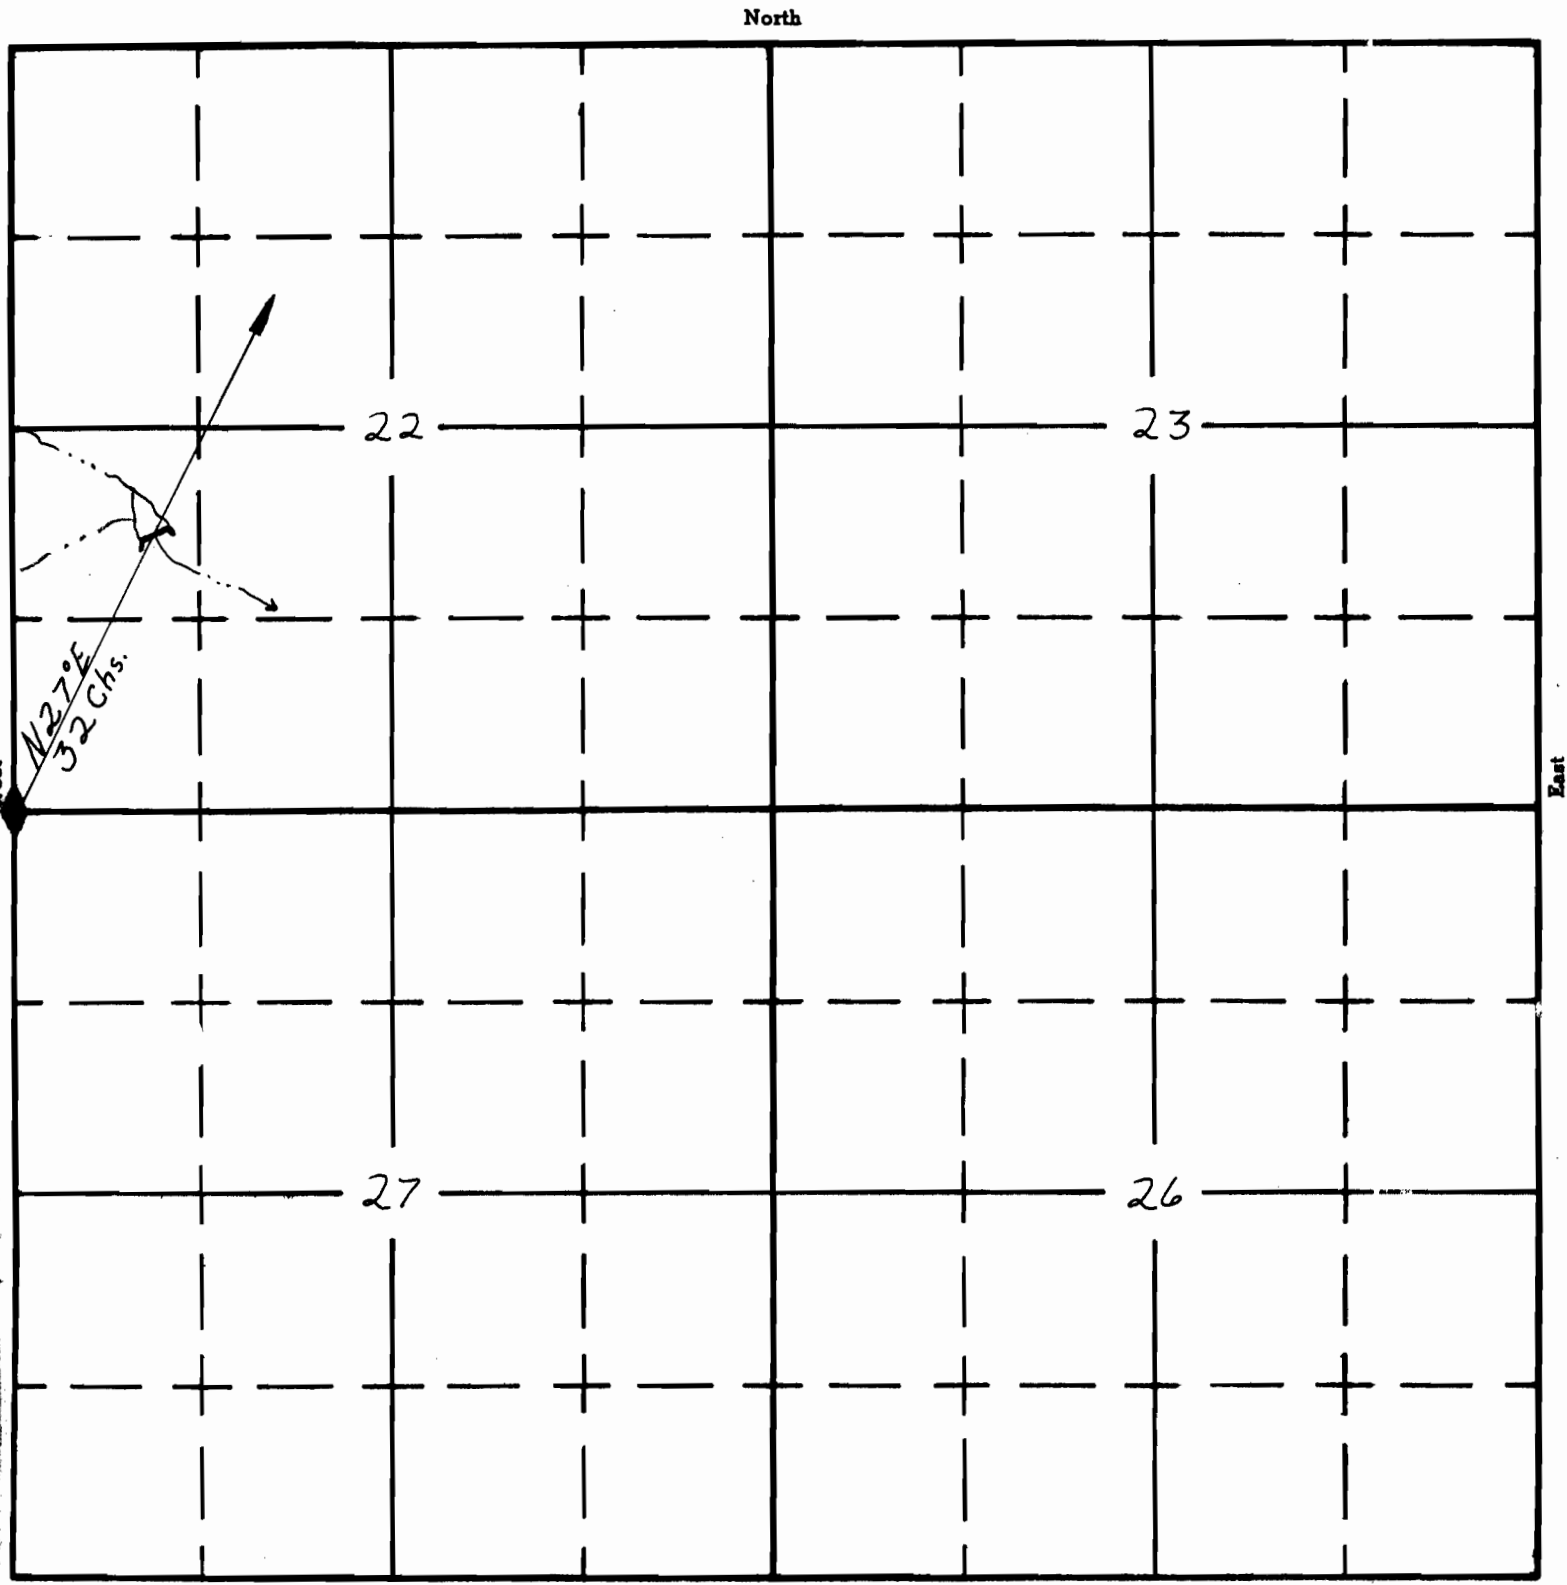

T. Cahill Res.
01-A-255
Blizzard Gap 7 1/2' quad

APPLICATION No. R-38588
PERMIT No. R-4345