

Form AI-187
March 1961

UNITED STATES
DEPARTMENT OF THE INTERIOR
BUREAU OF LAND MANAGEMENT

SECTION


21

Oregon State Water Filings

SE 1/4 SW 1/4

TOWNSHIP 40S, RANGE 26E, W. M.

North

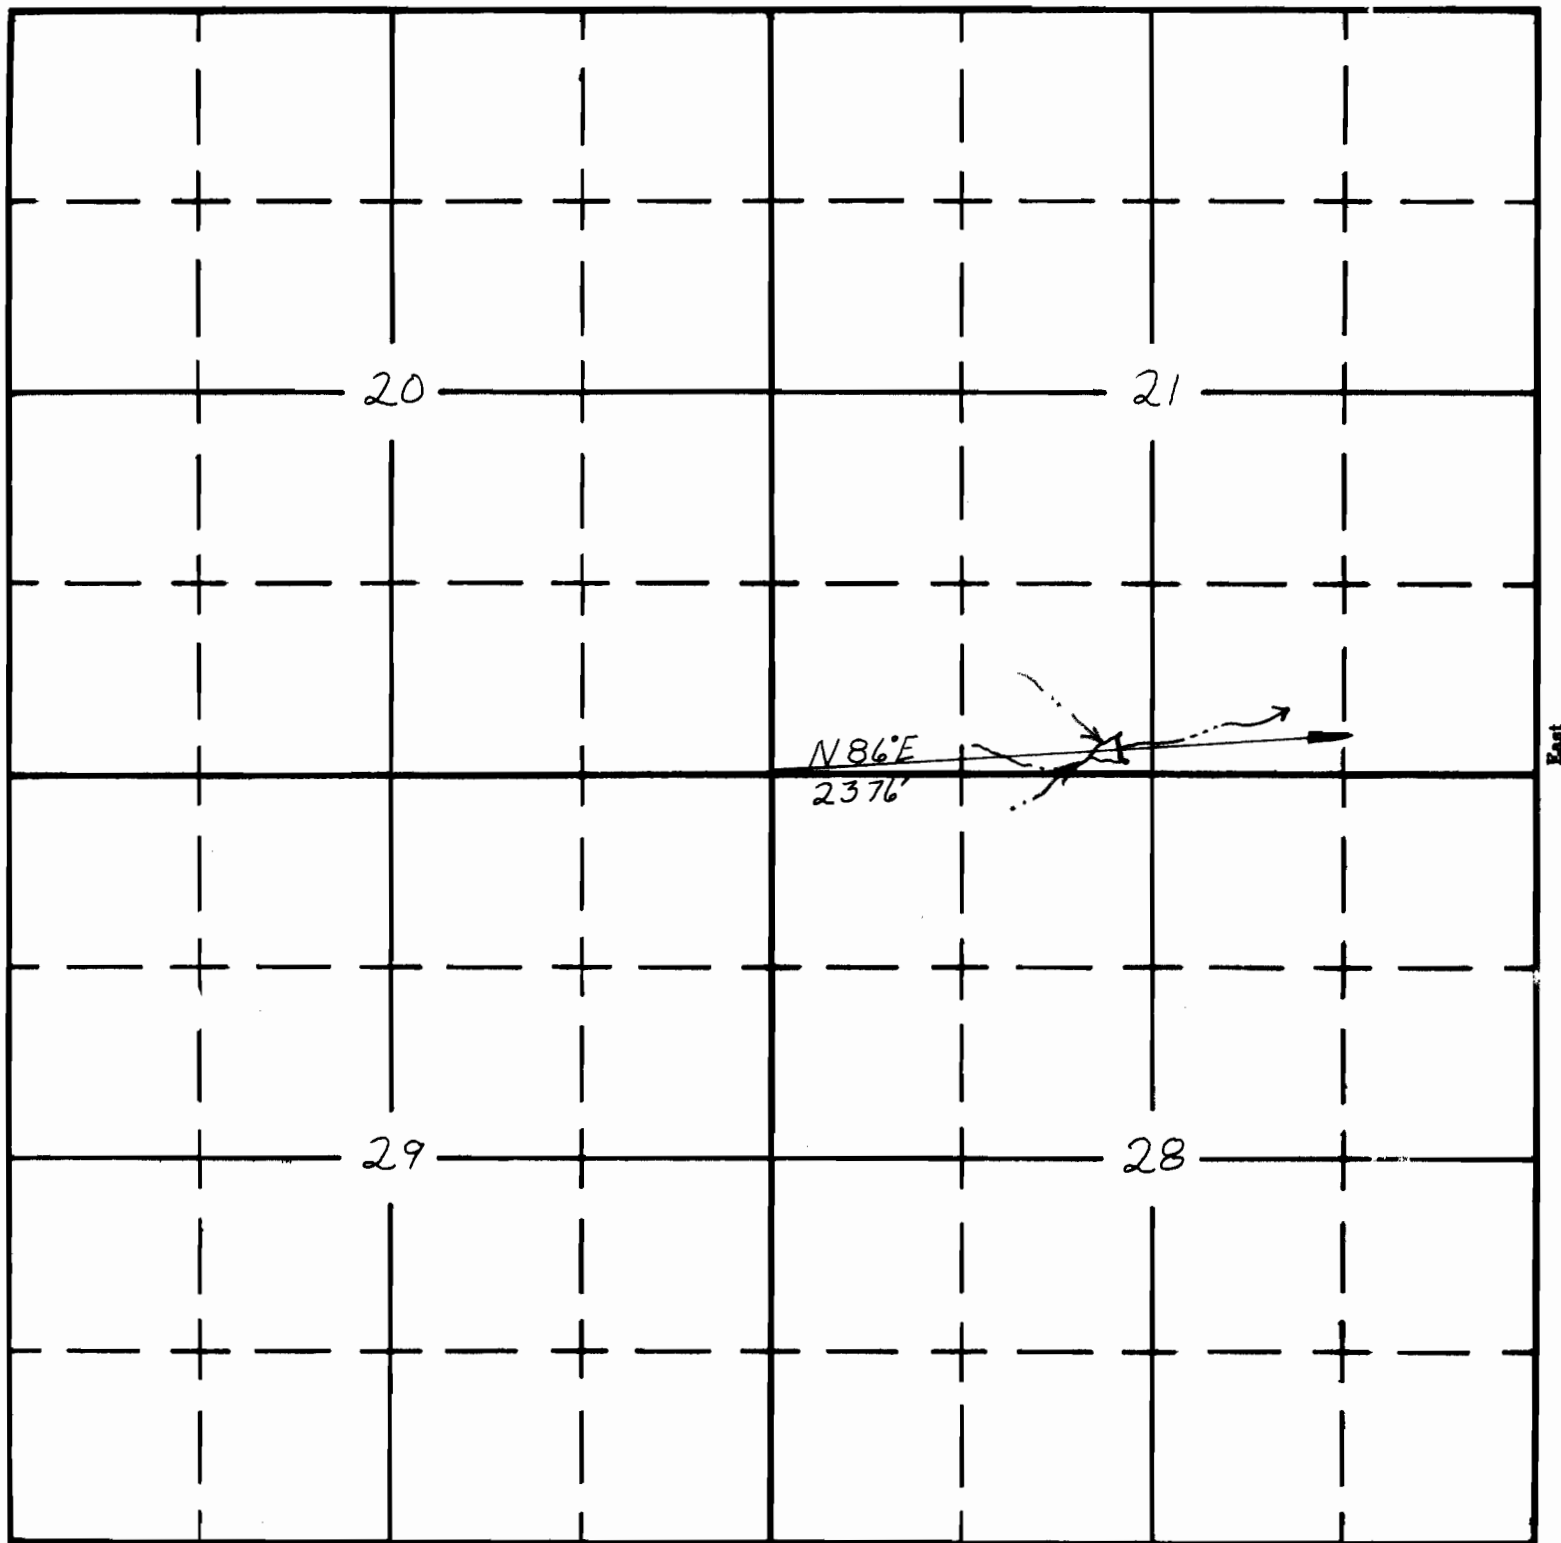

Betty Res. $7\frac{1}{2}'$ Blizzard Gap quad
01-R-251

South

APPLICATION No. R-38595
PERMIT No. R-4349