


Form AI-187
March 1961

UNITED STATES
DEPARTMENT OF THE INTERIOR
BUREAU OF LAND MANAGEMENT

SECTION 28 **Oregon State Water Filings**

~~SW 1/4 NE 1/4~~
~~NW 1/4 SE 1/4~~

TOWNSHIP 40S, RANGE 26E, W. M.

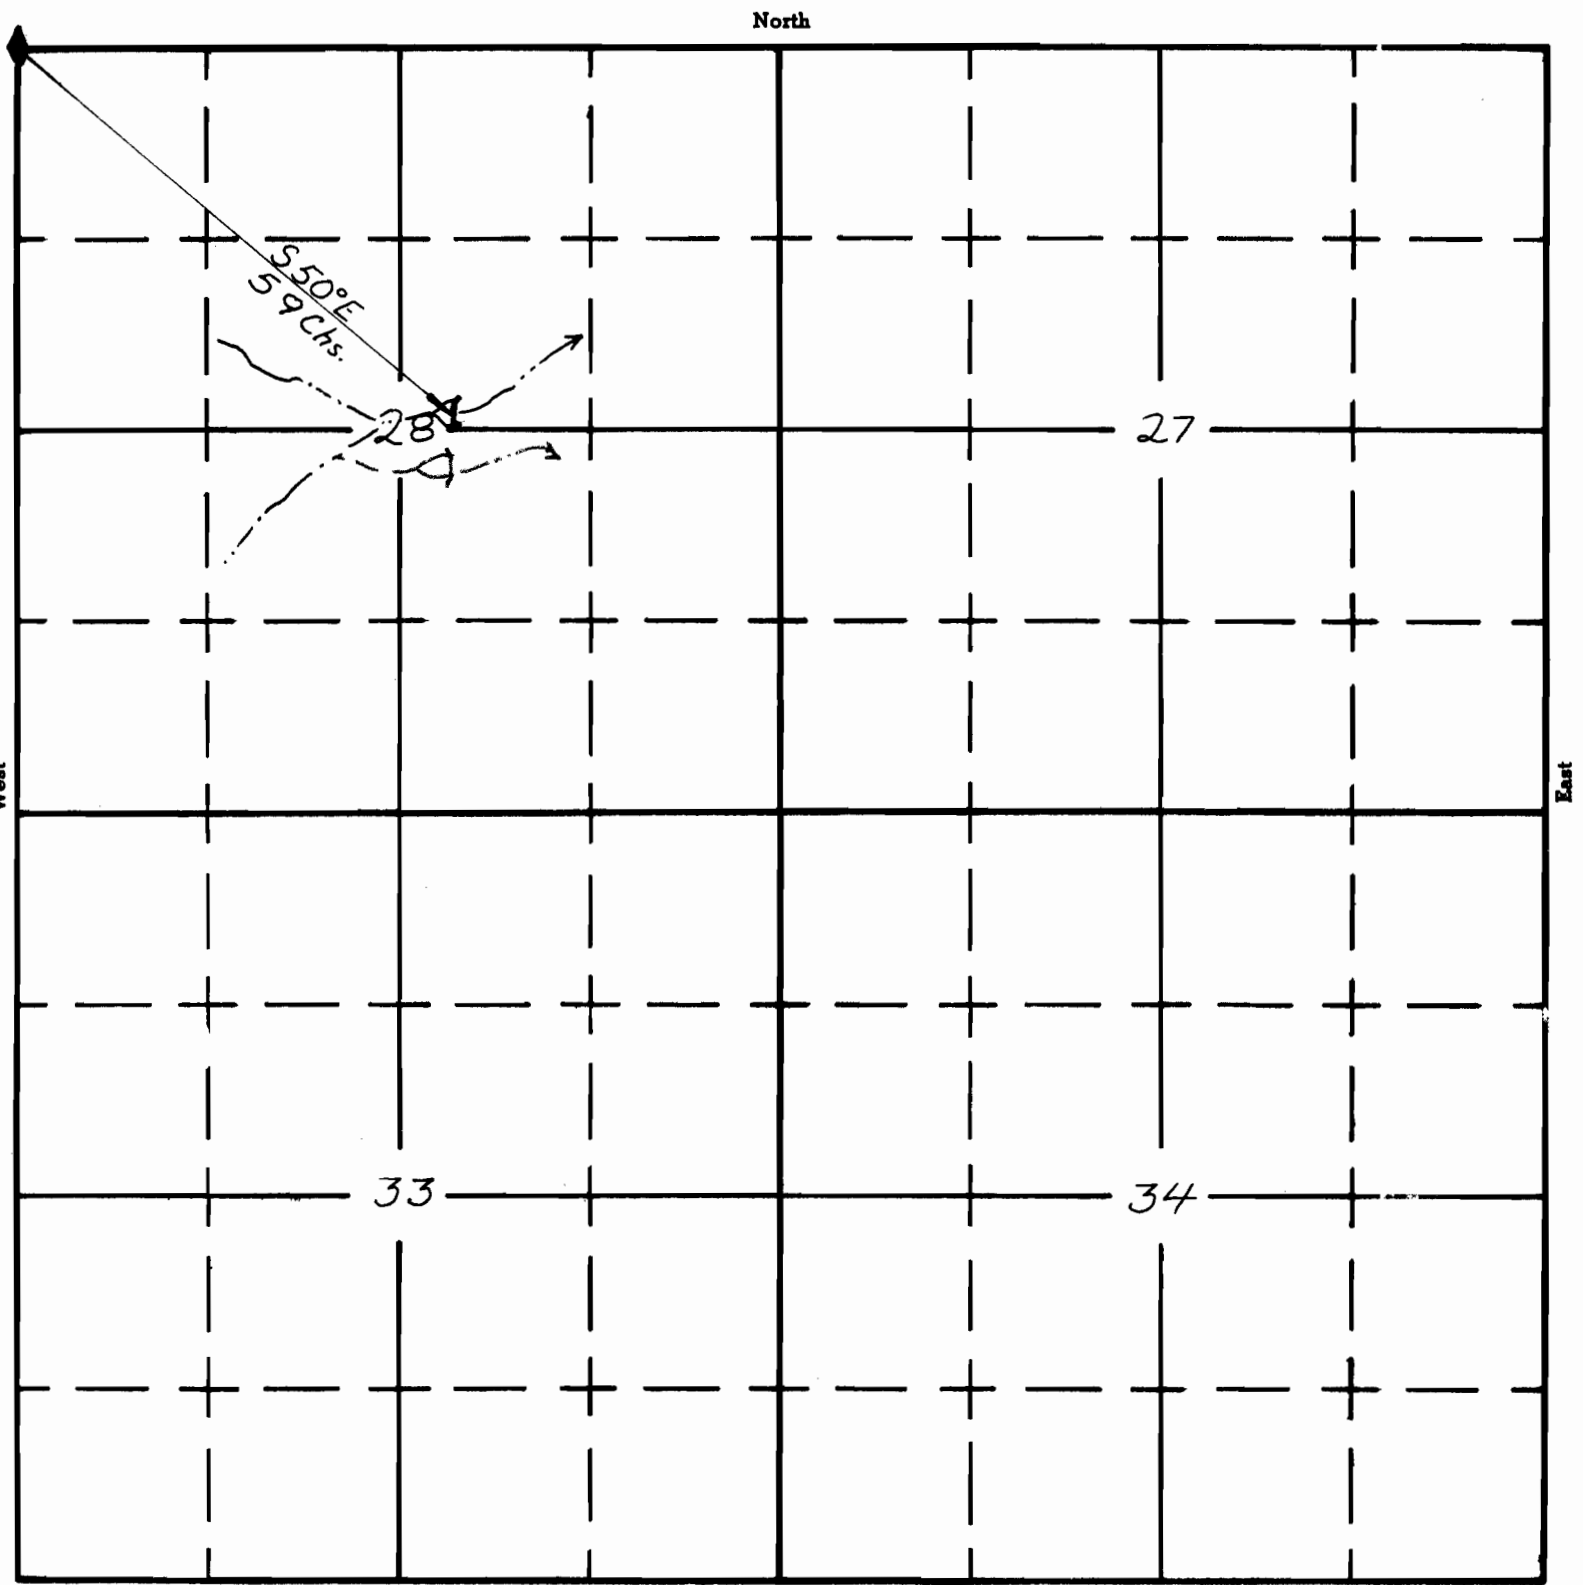

Claudia Res. 7 1/2' Blizzard Gap quad
01-R-252

APPLICATION No. P-38596
PERMIT No. R-4350