

Form A1-187
March 1961

UNITED STATES
DEPARTMENT OF THE INTERIOR
BUREAU OF LAND MANAGEMENT

SECTION


27

Oregon State Water Filings

SW 1/4 NW 1/4

TOWNSHIP 40S, RANGE 26E, W. M.

North

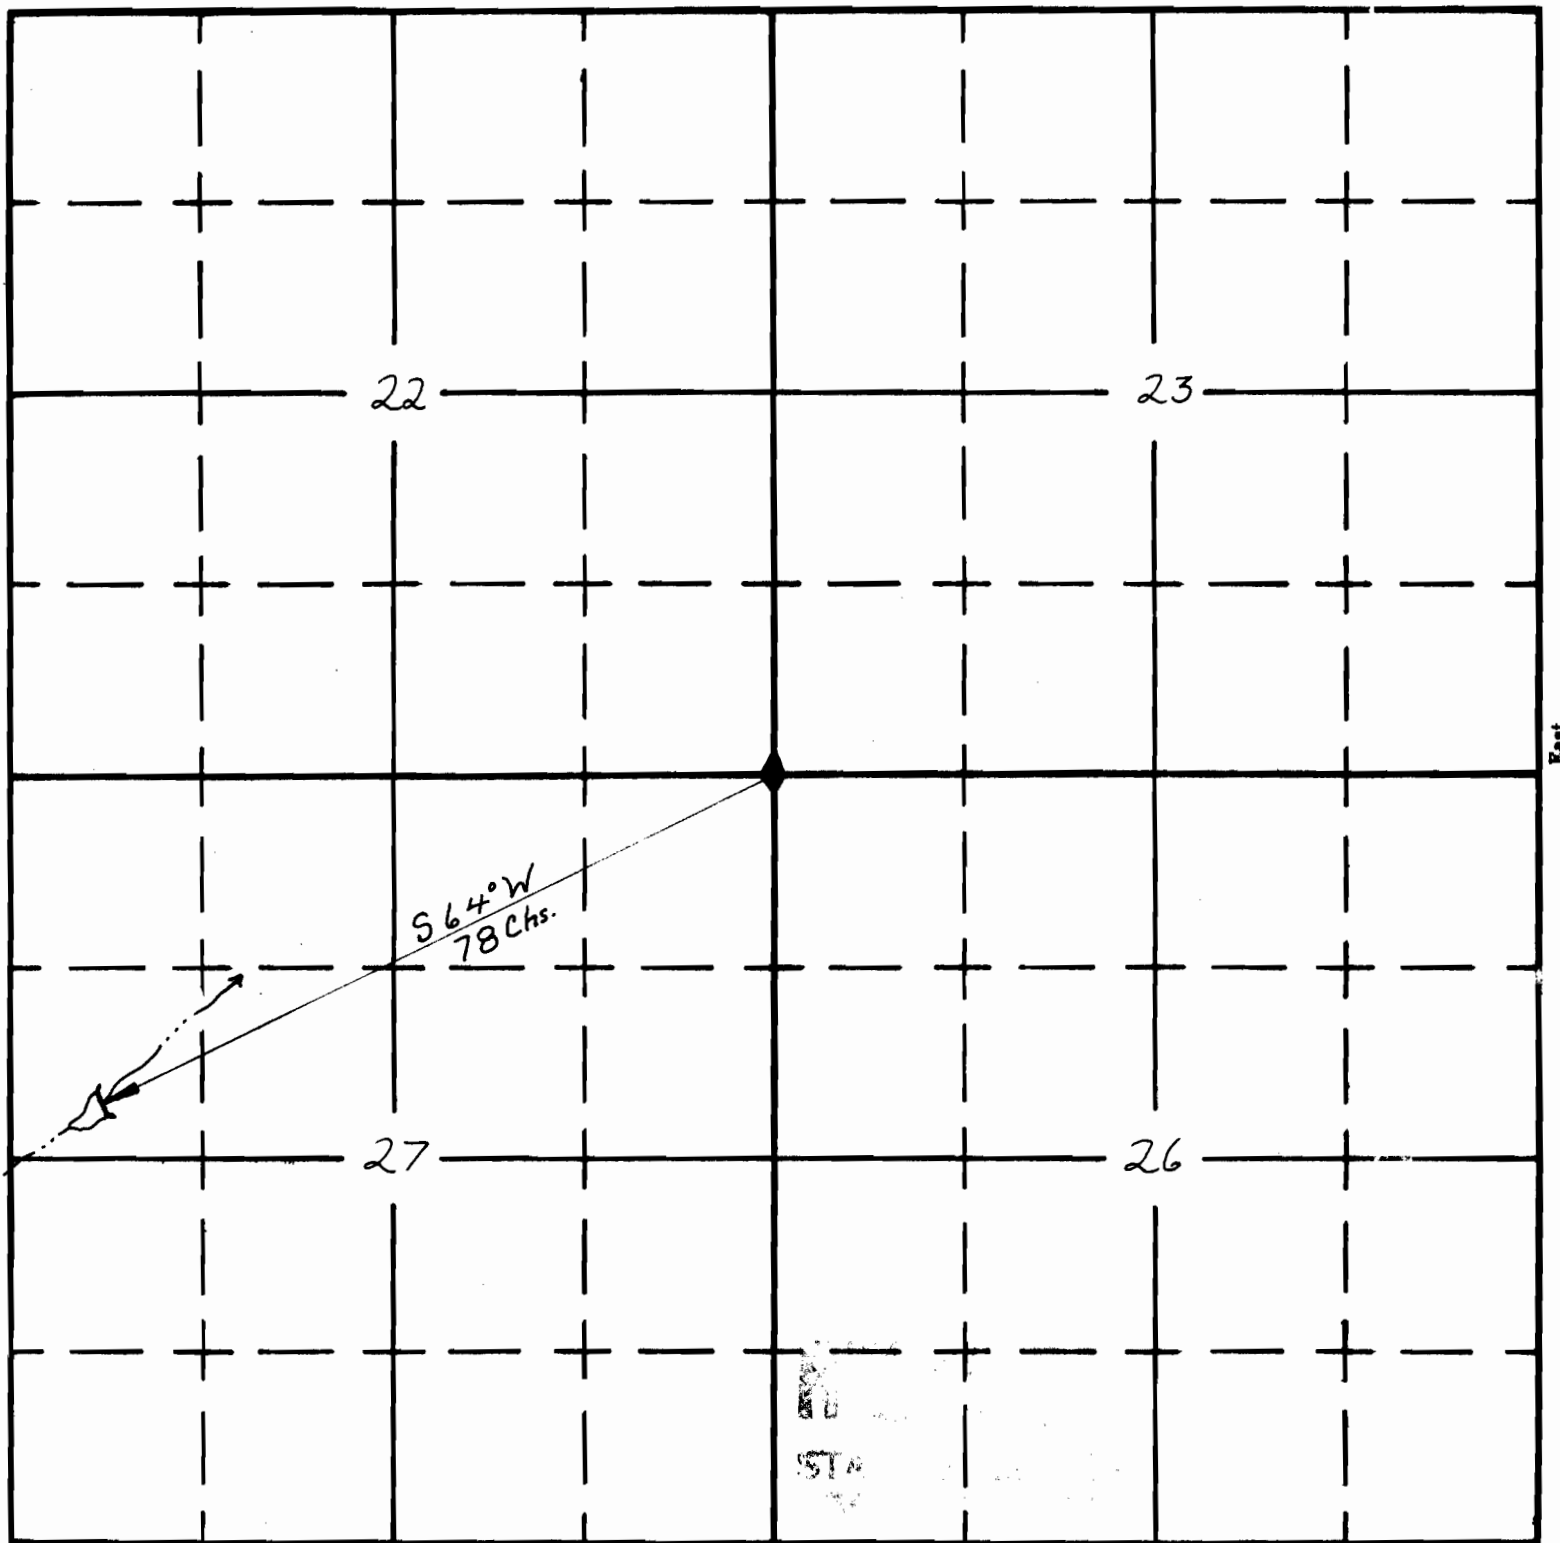

Clay Res.
01-R-256

Blizzard Gap 7 1/2' quad

APPLICATION No. R-38599
PERMIT No. R-4352