

1961

DEPARTMENT OF THE INTERIOR  
BUREAU OF LAND MANAGEMENT

R 4263  
51410


SECTION


31  
SW 1/4 NW 1/4

TOWNSHIP 40-S, RANGE 24-E, W. M.

North

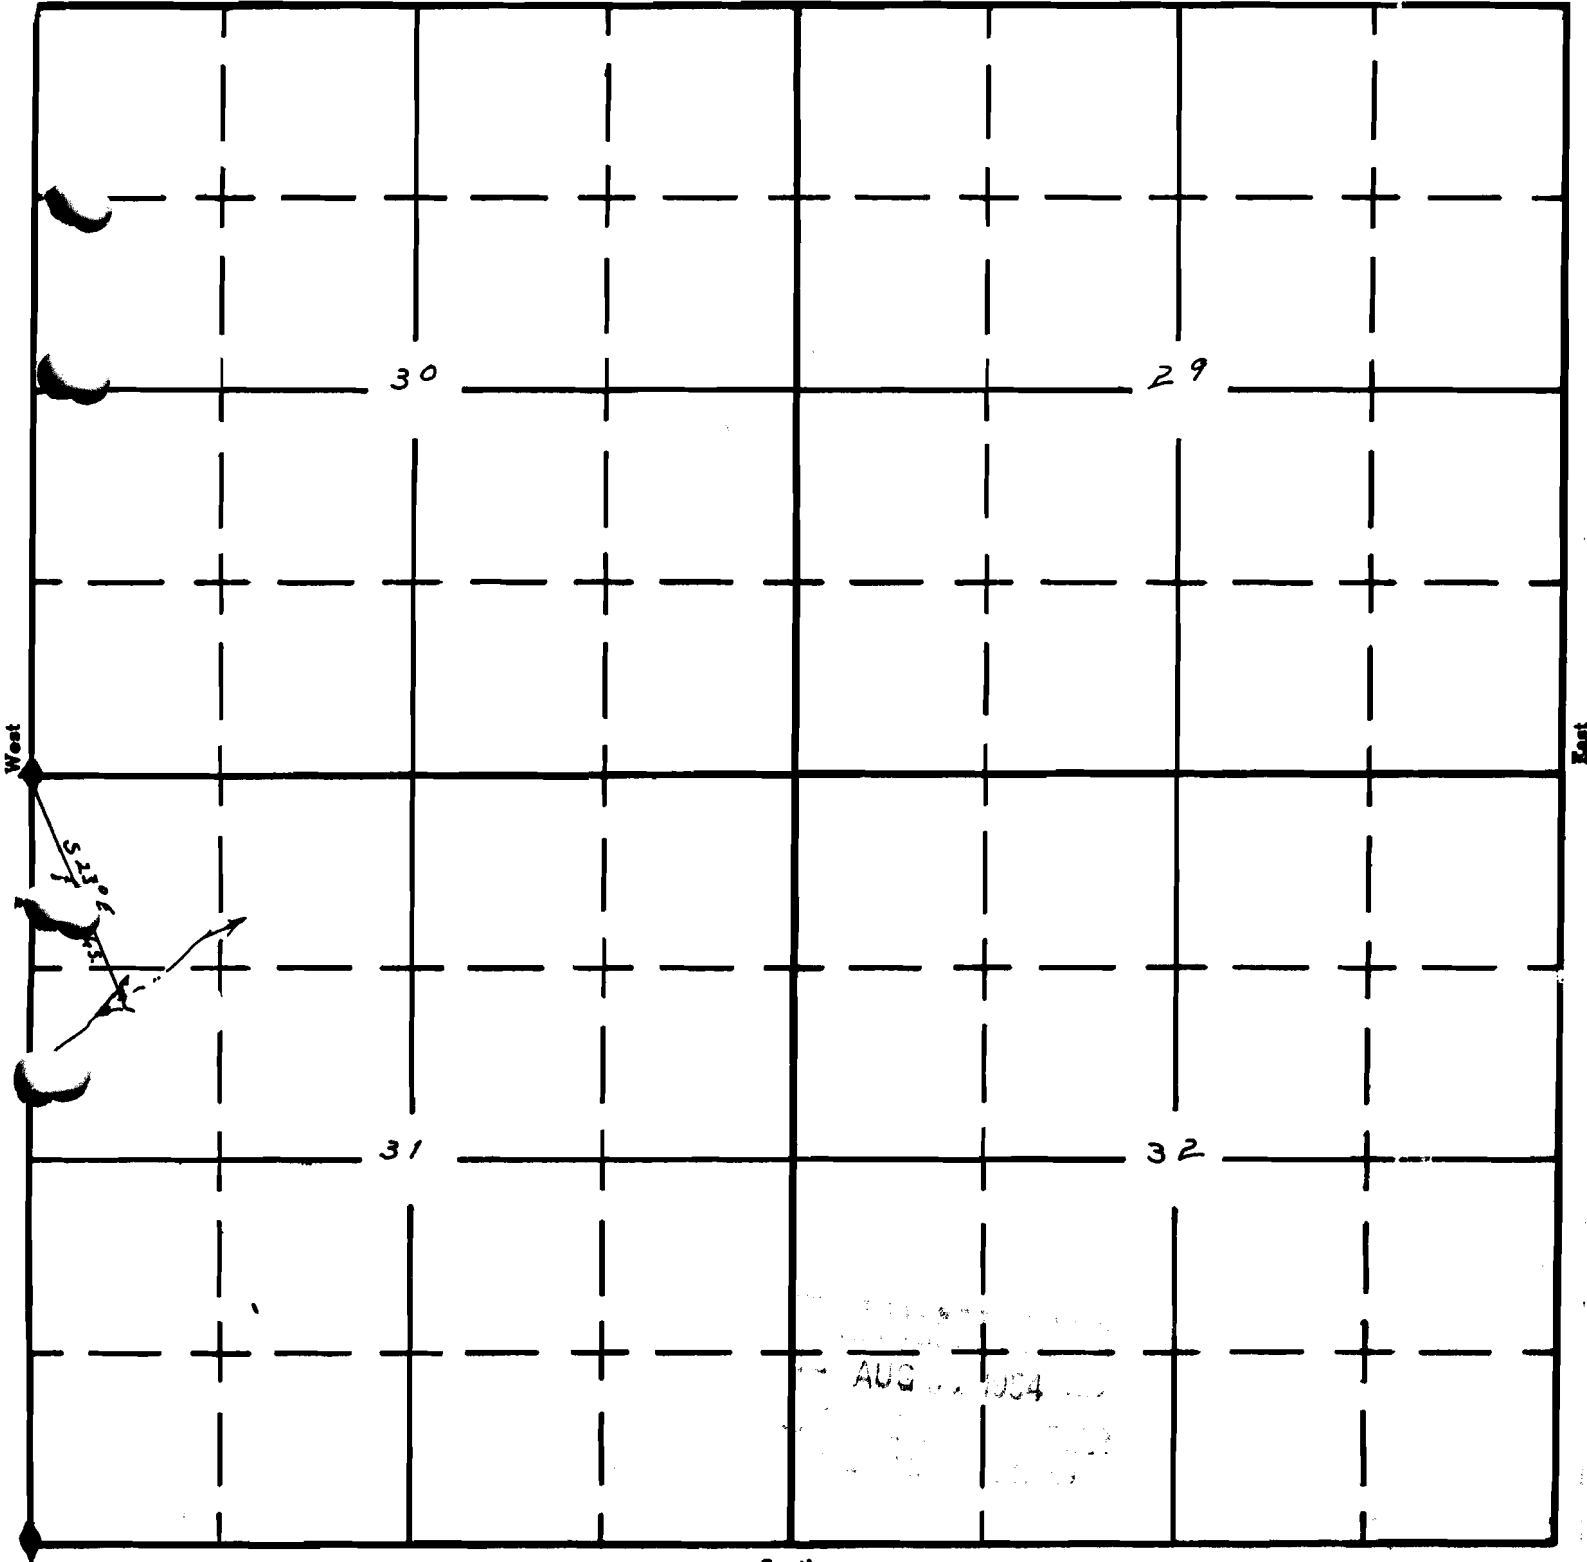

May Lake 7 1/2' quod

South

APPLICATION No. R-40327  
PERMIT No. R-4363